

MAP OF SURVEY


LOCATED IN

S.E. 1/4 OF SECTION 33, T. 37 S., R. 2 W., W.M.
JACKSON COUNTY, OREGON

FOR

CHARLES M. LINDSTROM

J. A. HOFFBUHR, REG. L.S., MEDFORD, OREGON
SCALE: 1"=100' OCTOBER 16, 1969
BASIS OF BEARING - SOLAR OBSERVATION
0-SET 5/8 X 24 IRON REINFORCING PIN

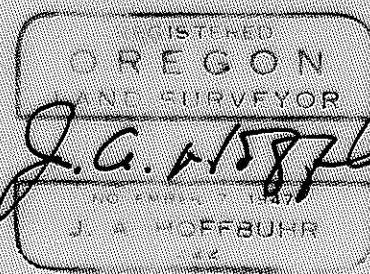

SURVEY NARRATIVE TO COMPLY WITH PARAGRAPH 209.250
OREGON REVISED STATUTES

SURVEY FOR: Charles M. Lindstrom
1035 Rosa Avenue
Sunnyvale, California



LOCATION: Tract situate in the Southeast One Quarter (1/4)
of Section 33, Township 37 South, Range 2 West,
Willamette Meridian, Jackson County, Oregon.

PURPOSE: To properly describe the tract of land intended to
be conveyed by Jackson County Deed Record, Volume
537, Page 348. Also to monument the corners of
said tract as shown on the attached map.

PROCEDURE: A tellurometer traverse was run from the Southwest
Corner of Donation Land Claim No. 44, Township 38 South, Range 2 West
to the 1-inch steel axle at the Junction of two fences. This axle
was set by the original unrecorded survey by L. E. Ager. The record
ties were found to be in error and the tract dimensions and bearings
were also incorrect and could not be closed mathematically. The
monument was used as the Southwesterly Corner of the original tract
described in said Deed Record, the bearings were oriented to true
bearings derived from a solar observation taken for this particular
survey. The tract is now correctly described. It is the intent of
the client and his predecessor to clear the title to the correct
description by obtaining quit claim deeds from the adjacent tract
owners on the East and South side of the correctly described parcel
of land.

Basis of bearings--Solar Observation

October 17, 1969

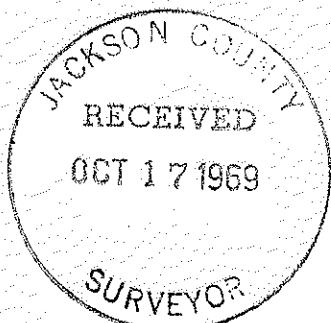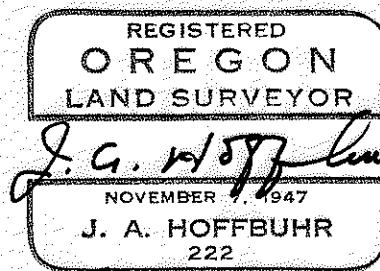

J. A. Hoffbuhr
Registered Land Surveyor