

**MAP OF SURVEY**  
 LOCATED IN  
 N.W. 1/4 OF SECTION 15, T.35 S., R. 1 W., W.M.  
 JACKSON COUNTY OREGON  
 FOR  
**R. C. BOHANNAN**

J. A. HOFFBUHR, REG. L.S., MEDFORD, OREGON  
 SCALE: 1"=100' MARCH 7, 1969  
 BASIS OF BEARING - R/S NO. 2603  
 o- SET 5/8" X 24" IRON REINFORCING PIN

REGISTERED  
**OREGON**  
 LAND SURVEYOR

*J. A. Hoffbuhr*  
 MEMBER 7 1947  
 J. A. HOFFBUHR  
 222

JACKSON COUNTY  
 RECEIVED  
 OCT 17 1969  
 SURVEYOR

SURVEY NARRATIVE TO COMPLY WITH PARAGRAPH 209.250  
OREGON REVISED STATUTES

SURVEY FOR: R. C. Bohannon  
Box 393, Highway 62  
Eagle Point, Oregon



LOCATION: Situated in the Northwest One Quarter (1/4) of  
Section 15, Township 35 South, Range 1 West,  
Willamette Meridian, Jackson County, Oregon.

PURPOSE: To establish the boundaries and prepare a legal  
description of the tract shown on the attached  
map.

PROCEDURE: The controls established for Recorded Survey No. 2603  
were used for this tract also.

Basis of bearings--Recorded Survey No. 2603.

October 15, 1969

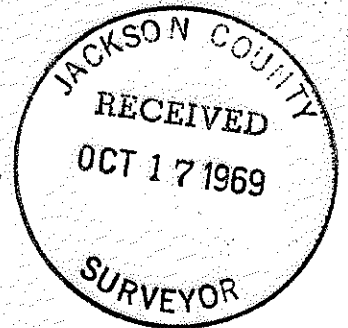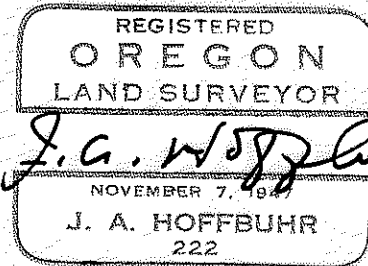

J. A. Hoffbuhr  
Registered Land Surveyor