

SURVEY NARRATIVE TO COMPLY WITH PARAGRAPH 209.250
OREGON REVISED STATUTES

SURVEY FOR: Wallace W. Watkins
111 East 8th Street
Medford, Oregon


LOCATION: Tract situated in the Southwest One Quarter (1/4)
of Section 33, Township 35 South, Range 2 West,
Willamette Meridian, Jackson County, Oregon.

PURPOSE: To monument the boundaries and properly describe
the two parcels as shown on the attached map.

PROCEDURE: The Southerly line of McMartin Lane was located by
found monuments of the "Land of Many Oaks", Addition No. 2, Recorded
Subdivision. The line from the Southeast Corner of Section 33 was
traversed and the parcels were described from this corner.

Basis of bearings--Solar Observation.

October 16, 1969

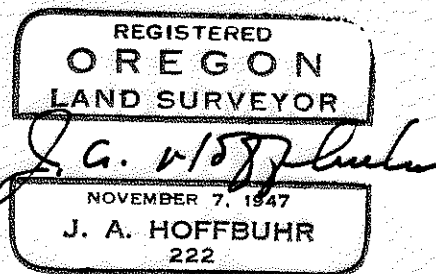

J. A. Hoffbuhr
Registered Land Surveyor

