

SW 1/4 SEC. 28  
T.37S., R.1W, W.M.

JACKSON COUNTY  
RECEIVED  
OCT 17 1969  
SURVEYOR

REGISTERED  
OREGON  
LAND SURVEYOR  
*J. A. Hoffbuhr*  
NOVEMBER 7 1947  
J. A. HOFFBUHR  
222

MAP OF SURVEY  
LOCATED IN  
LOT 6, BLOCK 6, SISKIYOU VILLAGE  
UNIT NO. 3, TO THE CITY OF MEDFORD  
JACKSON COUNTY OREGON  
FOR  
DR. HUGH GARDNER  
J. A. HOFFBUHR L.S. MEDFORD, OREGON  
SCALE: 1" = 40' 1-28-1969  
BASIS OF BEARING REC. SURVEY NO. 1346  
X = FD 5/8" IRON PIN  
o = SET 5/8" X 24" IRON REINF. PIN

SURVEY NARRATIVE TO COMPLY WITH PARAGRAPH 209.250  
OREGON REVISED STATUTES

SURVEY FOR: Dr. Hugh Gardner  
2949 El Dorado Drive  
Medford, Oregon



LOCATION: Tract situated in Lot 6, Block 6, Siskiyou Village  
Subdivision - Unit No. 3, also being within the  
Southwest One Quarter (1/4) of Section 28, Township  
37 South, Range 1 West, Willamette Meridian, Jackson  
County, Oregon.

PURPOSE: To monument the corners of Lot 6, Block 6, Siskiyou  
Village - Unit No. 3.

PROCEDURE: From monuments found on other Lots within the  
subdivision as indicated on the attached map the corner monuments  
were set as shown.

Basis of bearings--Recorded Survey No. 1346.

October 16, 1969

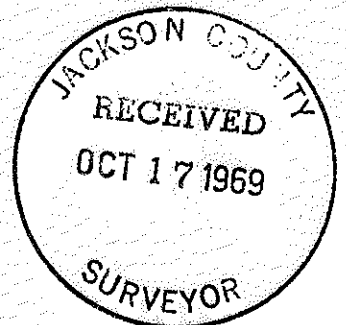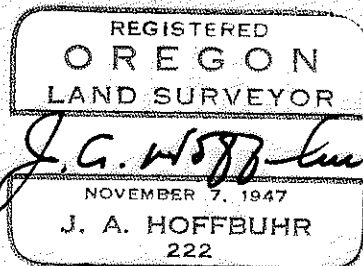

J. A. Hoffbuhr  
Registered Land Surveyor