


ROGUE RIVER



MAP OF SURVEY
 LOCATED IN
 S.E. 1/4 SECTION 29, T34S, R1W, W.M.
 N.E. 1/4 SECTION 32, T34S, R1W, W.M.
 N.W. 1/4 - S.W. 1/4 - S.E. 1/4 SECTION 20, T34S, R1W, W.M.
 N.W. 1/4 - S.W. 1/4 - N.E. 1/4 SECTION 32, T34S, R1W, W.M.
 N.W. 1/4 SECTION 4, T33S, R1W, W.M.
 JACKSON COUNTY GEORGE
 FOR
 ROGERS LOCUE LIVER LANCH

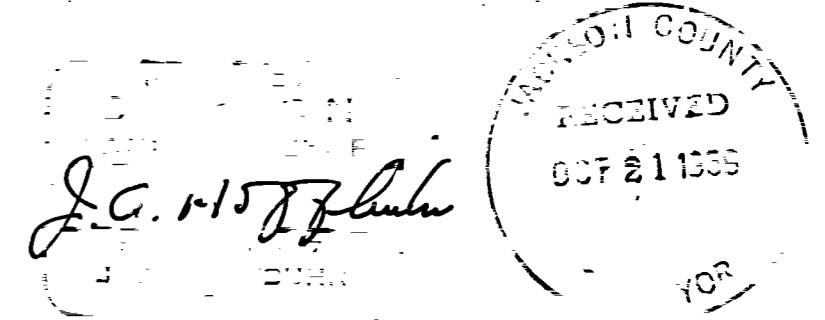

SURVEY NARRATIVE TO COMPLY WITH PARAGRAPH 209.250
 OREGON REVISED STATUTES

SURVEY FOR: Mrs. Lela Rogers
 Highway No. 62
 Shady Cove, Oregon



LOCATION: Tract situated in Section 4, Township 35 South,
 Range 1 West and in Sections 28, 29, 32 and 33,
 Township 34 South, Range 1 West, Willamette
 Meridian, Jackson County, Oregon.

PURPOSE: To determine the exterior boundaries of the tract
 of land shown on the attached map.

PROCEDURE: The Section Corner ties were made by tellurometer
 distances and angular measurements with a Wild T-2 Theodolite.
 The base station from which these distances were taken is the
 triangulation station on Vestal Butte situated approximately four
 miles East of the subject property. The corners used and found
 are as shown on the map. Several horizontal traverse checks were
 made to verify the information and no differences or errors were
 detected. The Center South One Sixteenth (1/16) Corner of Section
 28 had been previously set by County Survey, C. Z. Boyden, while
 in the process of subdividing the Section. The position was so
 close that it did not warrant setting another pin for the corner.
 The river boundary was determined by balancing the meander traverse
 notes between Section line ties.

Basis of bearings--Solar Observation.

October 17, 1969

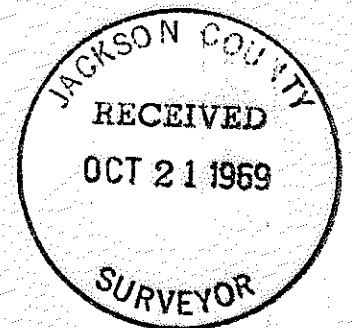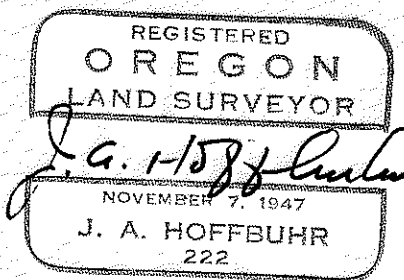

J. A. Hoffbuhr
 Registered Land Surveyor