


MAP OF SURVEY
 LOCATED IN
 SW 1/4 OF SEC. 3 & N.W. 1/4 OF SEC. 10 T.36 S.
 R. 1 W., W.M., JACKSON COUNTY OREGON
 FOR
 CHARLES E. KIMMEL
 J.A. HOFFBUHR REG. L.S. MEDFORD, OREGON
 SCALE: 1"=100'
 FEB. 4, 1969
 BASIS OF BEARING SOLAR OBSERVATION
 O = SET 5/8" X 24" IRON REINF. PIN (FLUSH)
 @ = FD 3/4" IRON PIPE-SET JUNE 24, 1969

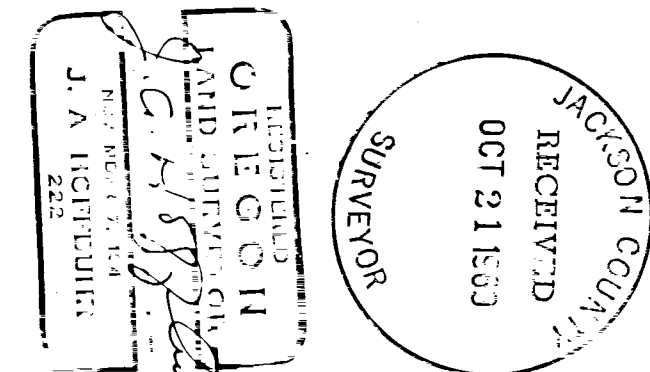


A = 229.33710"
 D = 109.00100"
 R = 572.96'
 L = 245.53'

A = 66.36125"
 D = 29.00100"
 R = 266.479'
 L = 330.35'

A = 159.24145"
 D = 69.00100"
 R = 95.4.93'
 L = 256.875'

A = 199.32150"
 D = 99.30100"
 R = 603.115'
 L = 205.76'

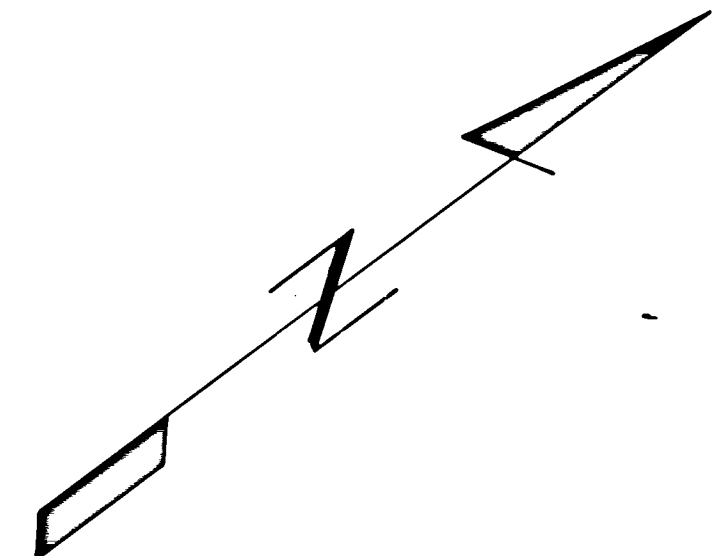

SURVEY NARRATIVE TO COMPLY WITH PARAGRAPH 209.250
OREGON REVISED STATUTES



SURVEY FOR: C. E. Kimmel
806 Shasta Avenue
Eagle Point, Oregon

LOCATION: Tract situated in the Southwest One Quarter (1/4)
of Section 3 and the Northwest One Quarter (1/4)
of Section 10, Township 36 South, Range 1 West,
Willamette Meridian, Jackson County, Oregon.

PURPOSE: To monument the corners and properly describe the
boundaries of the net tract described in Jackson
County Deed Records Volume 421, Page 371.

PROCEDURE: The control of previous surveys was used to establish
the Fryer's Division. The Westerly line of Little Butte Creek was
traversed and a search was made for the old road alinement shown in
the County Records for the County Road. By reason that no control
could be located, the existing centerline of the County Road was used
resulting in the right of way alinement used. The Donation Land Claim
Line was established from previous surveys. The tract was monumented
and described as shown.

October 15, 1969

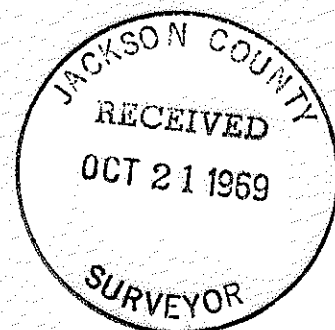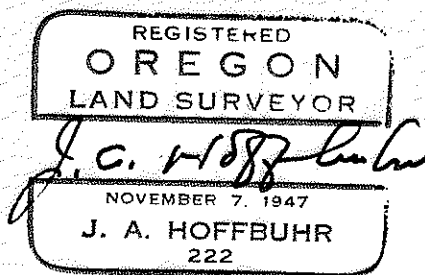

J. A. Hoffbuhr
Registered Land Surveyor