

4125

4125

N

BASIS OF BEARINGS: R./S. NO. 4085

SCALE 1"=300'

FD. BRASS CAP  
C.S. 1969 REESTAB

N. 1/4 COR. SEC. 9



N 89° 33' 30" W  
1340.34

GOV'T. RECORD N 89° 49' W 2630.76

N 89° 33' 30" W  
1340.34

4 3  
9 10 TWP 39S RIW  
FD. BRASS CAP  
C.S. 1969 REESTAB.

E 1/16 COR. SEC. 9  
SET 1/2" X 30" G.I. PIPE FLUSH

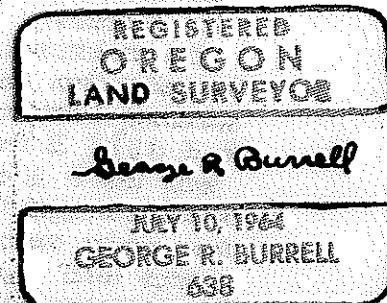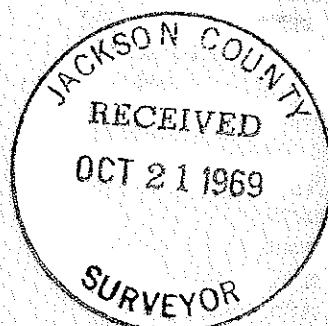

## MAP OF SURVEY

FOR  
HOWARD J. BOYD TALENT, OREGON  
OF  
THE N. LINE OF THE N.E. 1/4 SEC. 9 T39S RIW  
BY  
GEORGE BURRELL LAND SURVEYOR  
OCT. 7, 1969

4125

SURVEY NARRATIVE TO COMPLY WITH O.R.S. 209.250  
REVISED BY CHAPTER 555, O.L. 1963

FOR: Howard J. Boyd  
1867 Holton Rd.  
Talent, Oregon

PURPOSE: To monument the East 1/16 corner of Section 9,  
and to locate the line from this corner to the  
North 1/4 corner of Section 9 for timber cutting  
purposes.

PROCEDURE: A random line was run from the corner common to  
Sections 3,4,9 and 10 to the North 1/4 corner of  
Section 9. From this data the true position of  
the East 1/16 corner of Section 9 was calculated  
and monumented from a random line control point.  
A 4" x 4" x 48" fir wood post scribed E 1/16 S 4  
on the North face and scribed E 1/16 S 9 on the  
South face was set 18" in the ground approximately  
1 foot West of the 1/2" galvanized iron pipe set  
at the East 1/16 corner of Section 9. The true  
line from this corner to the North 1/4 corner of  
Section 9 was marked with wood stakes set on car-  
dinal offsets from the random line.

