

SURVEY NARRATIVE TO COMPLY WITH PARAGRAPH 209.250

OREGON REVISED STATUTES

Survey for: C. C. Corwin
1827 Pioneer Road
Talent, Oregon 97540

Survey by : Charles H. Hurst, L.S.
28 North Oakdale
Medford, Oregon 97501

Bearing : Based on government record adjusted to existing standing bearing tree.

Purpose : To replace a witness tree destroyed by logging operations on the Soda Vista Select sale, BLM contract no. 11-0008-11-475, at the west 1/16 corner on the south boundary of Section 32, Township 37 South, Range 3 East of the Willamette Meridian, Jackson County, Oregon.

Procedure

At the corner point monumented by an iron post $2\frac{1}{2}$ ins. diam., firmly set in the ground with brass cap marked according to the official government record, I find a 16 ins. diam. fir with scribing intact which bears $S77^{\circ}W$ 19.3 feet (Record 19.14 feet) and a 17 ins. diam. fir with scribing intact in the northeast quadrant down due to logging operations.

I take an additional bearing tree, a White fir, 18 ins. diam, which bears $N 70\frac{1}{2}^{\circ}E$ 42.1 feet dist. mkd. W 1/16 S32 BT.


Witness:

R.W. Malotte, chairman

cc: C. C. Corwin
BLM, Medford



Charles H. Hurst

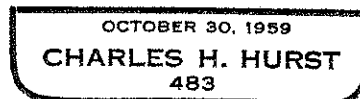

OCT 24 1969

