
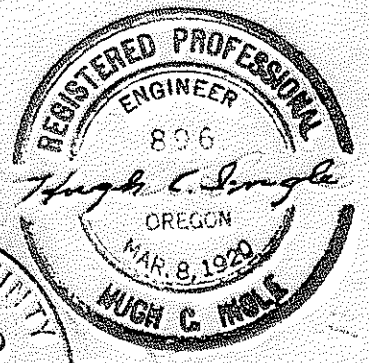


• Set 1/2" pins

SURVEY

For
 Ed. Soltis
 S.W. 1/4 Sec. 15 T. 35 S. R. 2 W.
 Jackson County, Oregon
 5c 4181" = 40' Hugh C. Ingle
 Civil Engineer

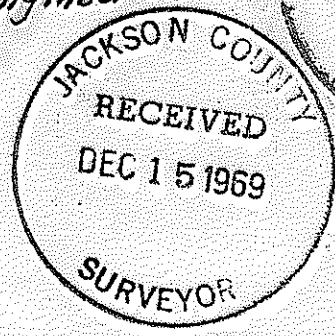

SURVEY NARRATIVE

TO Comply with O.P.S. 200.250

Survey For: Ed. Soltis, Meadows Road.

Survey By; Hugh C. Ingle, Civil Engineer.

Bearing; County Road Bearing.

Purpose: To locate property boundary as described in Record.

Procedure:

Found monument marking center of Section 15 on Center line of Meadows Road. Measured South from center of Section on road center line the distance of record to the beginning point, thence ran boundaries as called for in description and set corner pins.

Hugh C. Ingle

Hugh C. Ingle

Civil Engineer

