


4161
1915

SURVEY For JACKSON COUNTY ROAD DEPT.

SEC. 34, T. 36S., R. 2W., W.M.

JACKSON COUNTY, OREGON

OCT. 23, 1969

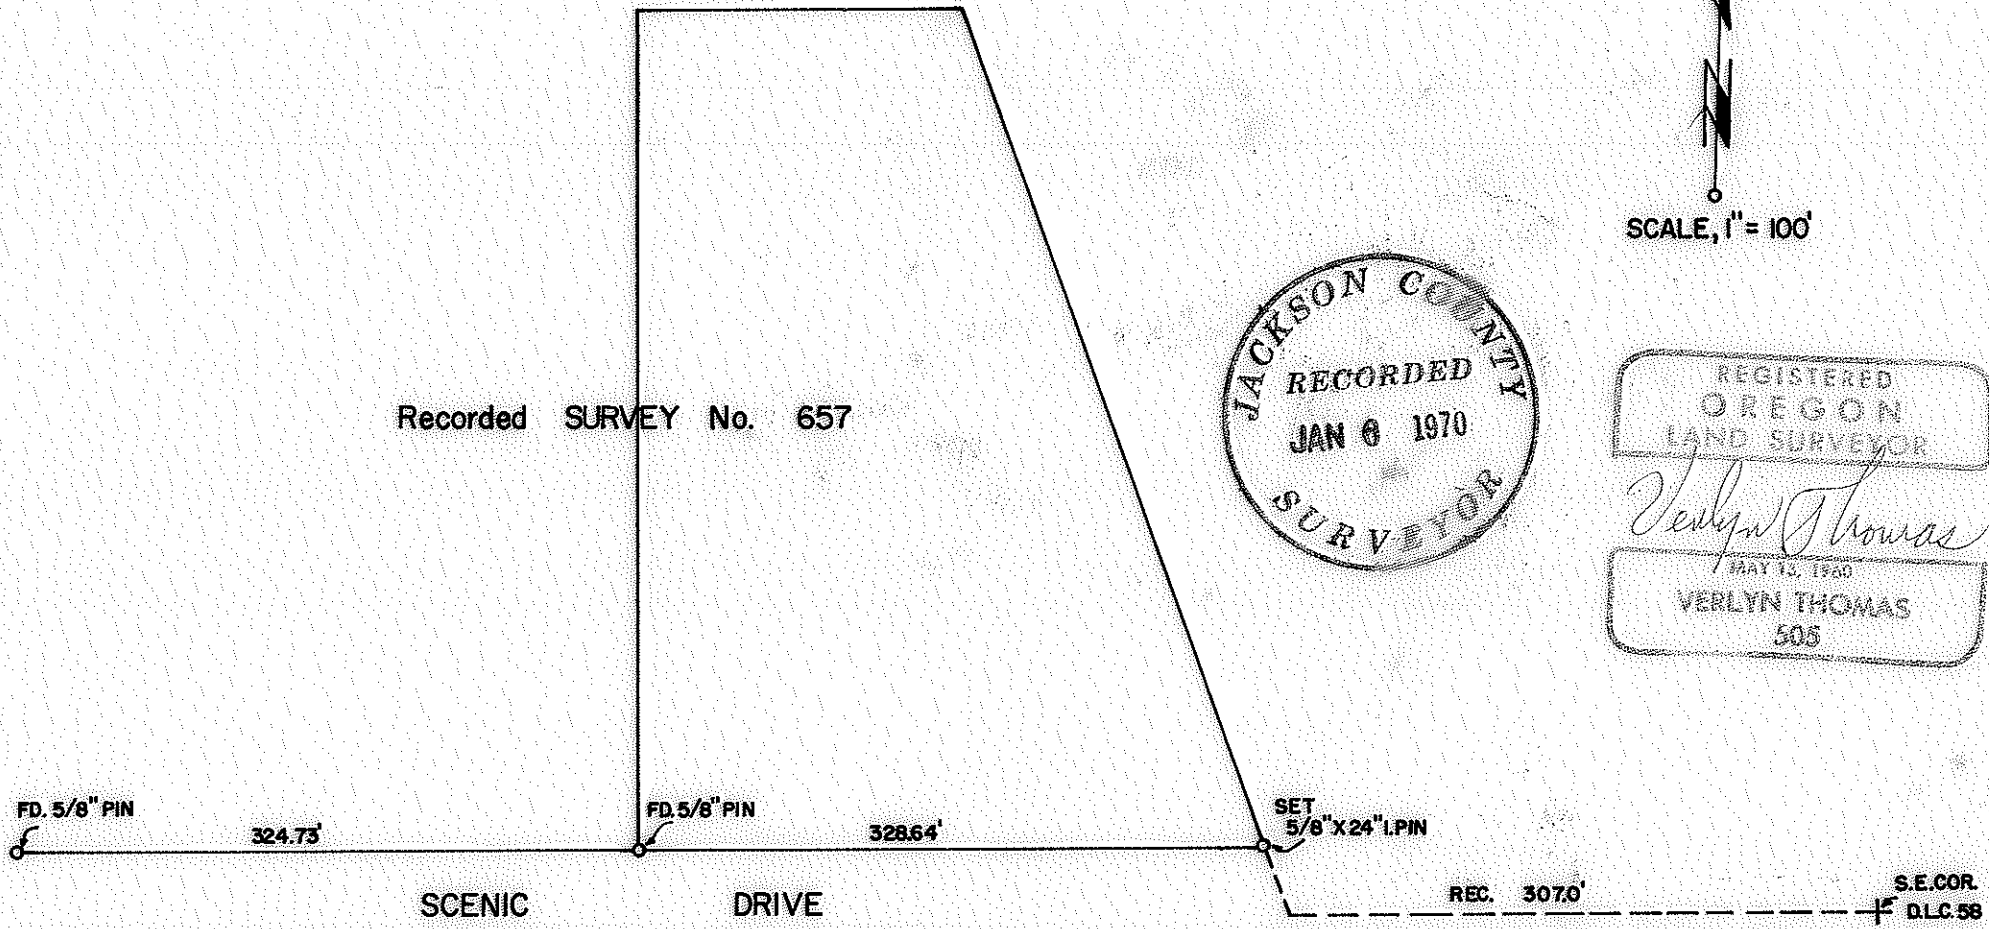

-4161

SURVEY NARRATIVE TO COMPLY WITH O.R.S. 209.250
REVISED BY CHAPTER 555, O.L. 1963

FOR: Jackson County Road Dept.
County Court House
Medford, Oregon.

PURPOSE: To replace a property corner apparently destroyed by roadside
ditch maintenance.

PROCEDURE: Recovered remaining property pins, and reset missing pin according
to Surveys of record, as shown on the accompanying Plat.

