

Butte Falls, Oregon
January 12, 1970

County Surveyor
Jackson County Courthouse
Medford, Oregon

SUBJECT: Corner restoration;
R2E S1 / S6 R3E
S12 / S7



T. 35S. W. M.

Found original evidence at old used corner which does not fit call notes. Location approximately 150' North of Butte Falls-Prospect Hiway.

- 38" D. Fir stump (logged 1970)
Section and BT scribes visible.
S62°E 44.3' to center.
- 61" D. Fir snag. Scribes visible.
S66°W 30.0' to center.

Set 5/8"x3" rebar and Aluminum cap at used corner location as established from BT faces and line blazes.
See attached affidavit by E.W. Smith.
See County Road Records for tie to corner prior to 1930.
Scribed RS 461 BT S6
8" W. Fir N69°E 10.9'

Scribed S1 RS 461 BT
10" W. Fir N47°W 14.3'

 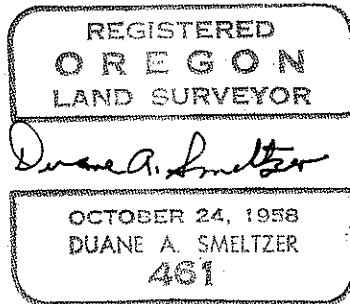

Butte Falls, Oregon
January 7, 1970

County Surveyor
Jackson County Courthouse
Medford, Oregon

Dear Sir;

Pertaining to SE. corner Section 1, T35S, R2E., W.M.

To best of my knowledge the corner (does not fit field notes) North of Butte Falls - Prospect Hiway has been established and used as the corner common to R2E S1 / S6 R3E by property owners prior to 1930.
S12 / S7

Other corner to South of County Road was not used or was not found.

I tied Rail Road survey and property lines to used corner about 1938. Believe four BTs and blazes were used to establish this corner. Believe scribes were removed from call BTs at other corner. Found $\frac{1}{4}$ corners to lie about Due East and West of used corner location.

Ernest W. Smith
Retired Medco Logging Engineer