

SURVEY NARRATIVE TO COMPLY WITH O.R.S. 209.250  
 REVISED BY CHAPTER 555, O.L. 1963

PURPOSE: Corner Re-establishments  
 On the Jackson County - Douglas County Line  
 Furnished by the Douglas County Surveyor

T. 32 S., R. 3 W. 1/4 corner to Sections 30 and 31.  
 Found - 18 x 12x 10" stone, firmly set, mkd. "1/4" on north face.  
 Original 24" Douglas Fir, now stump, N. 33° W. 12.5 ft., scribe visible.  
 Original 16" Douglas Fir, now stump, S. 87° E. 34.3 ft.  
 Set - Brass Cap at Cor. mkd:

County Surveyor's	T 32 S R 3 W	
Office		
1969		
	1/4	
	S 30	Douglas County
	S 31	Jackson County

New BT's: 31" Douglas Fir N. 7° E. 58.9 feet mkd: "1/4 S 30 CS BT"  
 45" Douglas Fir N. 81° E. 38.6 feet mkd: "1/4 S 30 CS BT"  
 No trees in Sec. 31 for good control, too far away in clear cut unit.

T. 32 S. R. 3 W. 1/4 corner to Sections 29 and 32.  
 Found - 18 x 14 x 6" Stone, firmly set, mkd: "1/4" on North face.  
 Original 36", now 44" Douglas Fir, N. 8° E. 15.8 feet, shows good scar.  
 Original 30" Douglas Fir, now rotted stump, S. 42° W. 11.2 feet opened for scribing.  
 Set - Brass Cap at Cor. Mkd:

County Surveyor's	T 32 S R 3 W	
Office		
1969		
	1/4	
	S 29	Douglas County
	S 32	Jackson County

New BT: 6" Douglas Fir S. 50° E. 25.4 feet, mkd: "1/4 S32 CS BT".

T. 32 S., R 3 W. Section Corner to Sections 28, 29, 32 and 33.  
 Found - 18 x 10 x 8" Stone mkd: 4 notches on E. & 1 on S., firmly set.  
 40", now 44" Douglas Fir, N 3° E. 48.2 feet, shows good scar.  
 6", now 16" Hemlock, S. 81° E. 23.1 feet, shows good scar.  
 40", now 46" Douglas Fir, S 76° W. 37.6 feet, shows good scar.  
 60" Douglas Fir, now 68", N 47° W. 8.6 feet.  
 Set - Brass Cap at Cor. Mkd:

County Surveyor's	T 32 S R 3 W	
Office		
1969		
	S 29	Douglas County
	S 32	Jackson County
	S 28	Douglas County
	S 33	Jackson County

New BT's: 10" Cedar N. 60° E. 17.0 feet mkd: "T32S R3W S28 CS BT"  
 14" Hemlock S. 22° W. 14.0 feet mkd: T32S R3W S32 CS BT"

T. 32 S. R. 3 W. Section Corner to Sections 26, 27, 34, and 35.  
Found - Corner Stone, 15 x 8 x 8", firmly set mkd. with notches.  
Original 20" Douglas Fir, now stob, N. 14° E. 4.6 feet, scribe visible.

Original 18" Douglas Fir, now stob, N. 48° W. 7.3 feet, found reverse scribe.

Original 12" Douglas Fir, now burnt stob, S. 45° W. 10.6 feet stob flush with ground.

Original 16" Douglas Fir, now stob, S. 60° E. 17.2 feet, scribing rotted out.

Set - Brass Cap at corner mkd:

County Surveyor's  
Office  
1969

T. 32 S. R. 3 W.

S 27 | S 26 Douglas County  
S 34 | S 35 Jackson County

New BT's: 6" Hemlock S. 18° W. 19.0 feet mkd: "T32S R3W S34 CS BT".  
6" Hemlock S. 66° E. 4.4 feet mkd: "T32S R3W S35 CS BT"  
8" Hemlock N. 69° E. 5.9 feet mkd: "T32S R3W S26 CS BT"  
6" Hemlock N. 15° W. 20.2 feet mkd: "T32S R3W S27 CS BT".

T. 32 S. R. 3 W. 1/4 Corner to Sections 25 and 26.  
Found - 18 x 12 x 6" stone mkd: "1/4" on West face, firmly set at corner.  
10", now 13" Cedar, N. 30° E. 12.5 feet, shows good scar.  
12", now 14" Cedar, N. 82° W. 17.8 feet, scribe marks visible but mostly grown over.  
Set - Brass Cap at Corner mkd:

County Surveyor's  
Office  
1969

T 32 S R 3 W

1/4 S 26 | S 25

All bearing trees O.K. and tagged.


T. 32 S. R. 3 W. 1/4 Corner to Sections 28 and 33.  
Found - 16 x 12 x 10 stone mkd: "1/4" on North face, firmly set at 1/4 Corner.  
48", now 82" Douglas Fir, S. 50° W. 33.0 feet, shows faint scar.  
20", now 39" Douglas Fir, N. 10° E. 31.7 feet, shows good scar.  
Set - Brass Cap at Corner Mkd:

County Surveyor's  
Office  
1969

T32S R3W

S 28 Douglas County  
1/4 S 33 Jackson County

Reblazed and Rescribed: 82" Douglas Fir S. 50° W. 33.0 feet mkd: "1/4 S33 CS BT". 9/5/69

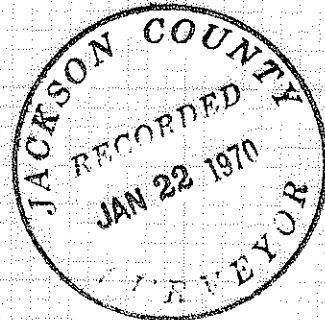

48" Douglas Fir, now snag, S. 35° W. 17.8 feet, scribe visible  
 54", now 72" Douglas Fir, N. 44° W. 37.6 feet, shows good scar.  
 New BT's: 17" Yellow Pine, N. 21° E. 31.5 feet mkd: T32S R3W S25 CS BT"  
 18" Douglas Fir, S. 70° W. 40.2 feet mkd: T32S R3W S35 CS BT"  
 7" Douglas Fir, S. 41° E. 16.2 feet mkd: T32S R3W S36 CS BT"  
 (unrecorded) 36" Cedar S. 4° E. 32.0 feet mkd: "RS 359".

T. 32 S. R. 3 W. Section Corner to Sections 27, 28, 33, and 34.  
 Found - Corner stone, 15 x 6 x 6", firmly set mkd: 1 notch S. and 3 notches E.

Original 28", now 36" Douglas Fir, N. 83° E. 34.3 feet, shows good scar.

Original 40", now 48" Douglas Fir, S. 82° E. 31.0 feet, shows good scar.

Original 40", now 45" Douglas Fir, N. 82° W. 10.6 feet shows good scar.

Original 30", now 40" Cedar, S. 7° W, 67.3 feet, shows good scar.  
 Set - Brass Cap at Cor. mkd:

County Surveyor's Office 1969	T32S R3W
	S 28   S 27
	S 33   S 34

All BT's O.K. and tagged; Corner about on top of rounded spur, running West

T. 32 S. R. 3 and 4 W. Section Corner to Secs. 25 and 36, T 32-4 W. (West boundary T 32-3 W)

Found - No trace of Corner Stone.

Original 24", now 28" Douglas Fir, S. 75° W. 21.8 feet, shows good scribing.

Original 12", now 16" Sugar Pine, N. 1° W. 68.6 feet, shows good scribing

Set - Brass Cap at Cor. mkd:

County Surveyor's Office 1969	T 32 S
	R S 25   R
	4   S 30 3
	W S 36   W

No new bearing trees needed. This corner lies about 100' north of creek.

T. 32 S. R. 3 W. 1/4 Corner to Sections 27 and 34.

Found - Corner stone 12 x 10 x 5", firmly set, mkd. "1/4" on north face.

Original 30", now 38" Douglas Fir, N. 14° W. 6.6 feet, shows good scar.

Original 8" Hemlock, now stob, S. 20° E. 4.0 feet, opened for scribe.

Set - Brass Cap at Corner mkd:

County Surveyor's Office 1969	T 32 S R 3 W
	S 27 Douglas County
	1/4 _____
	S 34 Jackson County

New BT: 8" Hemlock S. 42° E. 22.7 feet mkd: "1/4 S34 CS BT".