


SURVEY IN S.E. 1/4 SEC. 15, T.35S., R.2W., W.M.
 FOR
 FAYDREX, INC.
 69 - 24

BY EDWARD MCGINTY
 MEDFORD, OREGON
 JANUARY 1970

SCALE: 1" = 100'
 O = SET 5/8" X 24" I. PIN

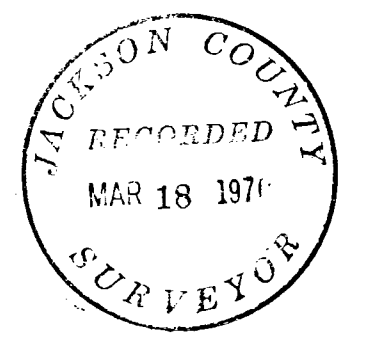

SURVEY NARRATIVE TO COMPLY WITH O.R.S. 209-250

Survey for: Faydrex, Inc. Ref. 69-24
1054 So. Riverside
Medford, Oregon

Survey by: Edward A. McGinty, R.S.
Medford, Oregon
Jan. 1970

Basis of Bearing: Survey No. 3948.

Precedence of Survey:

The easterly line of this survey, being the easterly line of Section 15. The Northerly line of this survey was determined from deed record distance North from the Southeast Section corner and a deed record angle of 90°00 from the Section line. The tract of land lying north of this survey would indicate a surplus distance when compared to deed record distance.

Center line of Dodge road was determined from monuments found and previous survey No. 3948.

The center line of Meadows road was determined from the S.1/4 corner and theoretical N.1/4 corner by county survey R.P.'s.

MONUMENTS:

Set 5/8 in. x 24 in. iron pins.

- A. The N.1/4 corner from county survey R.P.s to the South east being 1 in. iron pipe, approx. 2 ft. deep, 18.46 ft. East of the center line per county data.
- B. Found a 5/8 in. iron pin, approx. flush with the surface at the S.1/4 cor.
- C. Found 1 1/2 in. iron pipe near the fence line. the SE. cor. of Sec. 15.
- D. Found 1 in. iron pipe near fence. The E.1/4 cor.

