
FEBRUARY 24,1970

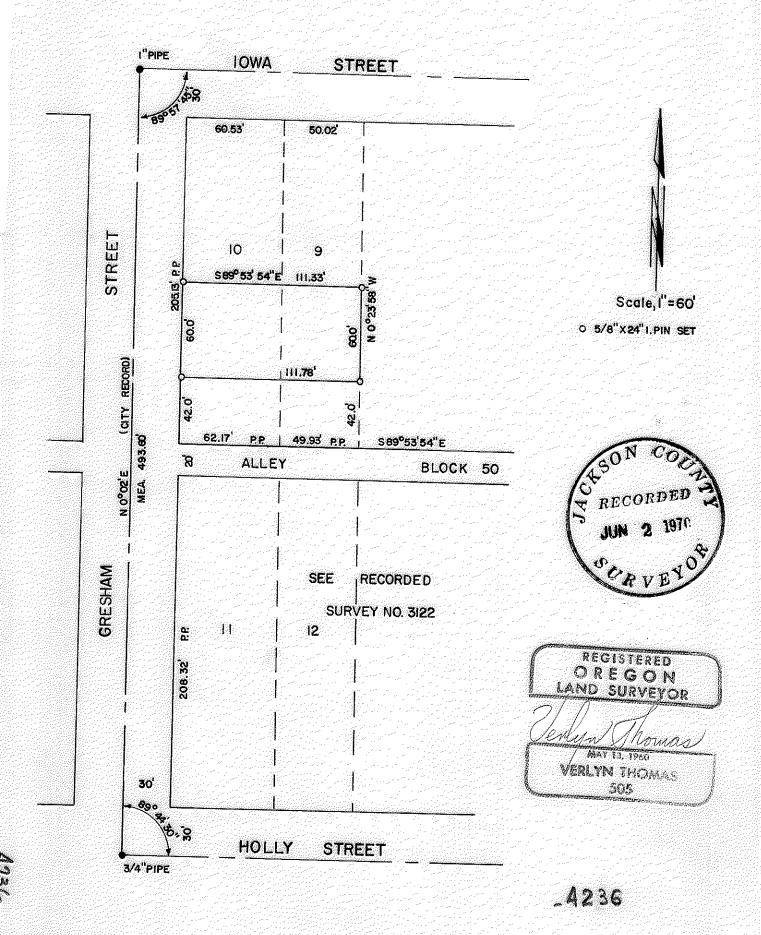

SURVEY NARRATIVE TO COMPLY WITH O.R.S. 209.250 REVISED BY CHAPTER 555, O.L. 1963.

FOR:

Mr. John Otstot 406 Iowa Street Ashland, Oregon.

PURPOSE:

To survey and monument a residential parcel in SUMMIT ADDITION, according to legal description.

PROCEDURE:

Determined pro-rate data from measurements previously made in performing Recorded Survey No. 3122, and from control established and recovered, monumented parcel as shown on the accompanying plat.



REGISTERED OREGON LAND SURVEYOR

VERLYN THOMAS

Could