



SURVEY FOR LILLIAN HUKILL  
SEC'S 18 & 19, T.39S., R.2W., W.M.  
JACKSON COUNTY, OREGON  
December 31, 1969.

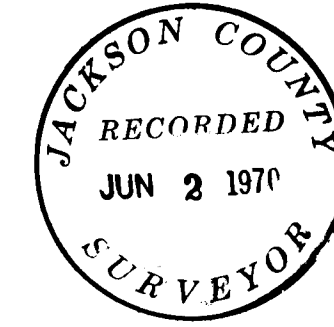

REGISTERED  
OREGON  
LAND SURVEYOR  
*Verlyn Thomas*  
MAY 11, 1960  
VERLYN THOMAS  
505

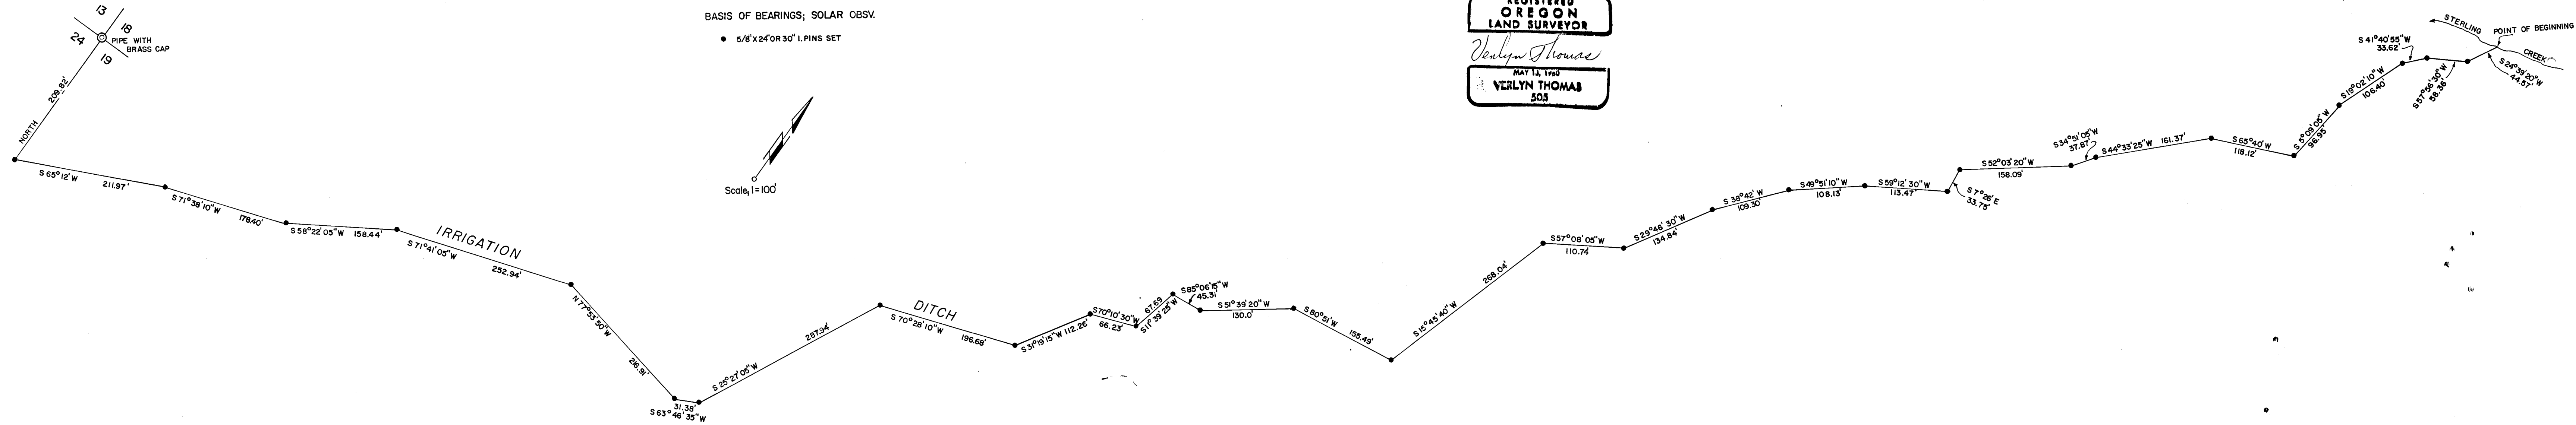

SURVEY NARRATIVE TO COMPLY WITH O.R.S. 209.250  
REVISED BY CHAPTER 555, O.L. 1963.

FOR: Lillian Hukill  
Sterling Creek Road  
Jacksonville, Oregon.

PURPOSE: To survey and locate an existing irrigation ditch for purpose of preparing a description for easement, and to monument same.

PROCEDURE: Monumented angle points in the ditch with  $\frac{5}{8}$ " iron pins. Monuments which fell in ditch bottom were buried wherever possible to prevent their disturbance by ditch maintenance. A closed traverse was conducted through these angle points, and tied to the Section corner common to Sections 13, 18, 19, and 24, and a description prepared.



*Verlyn Thomas*

