

SUR. NO. 3693

SEC 23

HYWAY
238

N 0°43'45" E
638.34'



REGISTERED
OREGON
LAND SURVEYOR

Edward A. McGinty

JULY 10, 1955
EDWARD A. MCGINTY
301

SURVEY IN N. 1/2 SEC. 23, T38 S., R. 3 W., WM.
FOR
C. P. OLSON
66-29-3

BY EDWARD A. MC GINTY
MEDFORD OREGON
MARCH 1970

SCALE 1" = 100'
○ = 5/8" I. PIN
● = 5/8" I. PIN FD.
⊙ = 1" I. PIPE FD.

Survey No. 4243

SURVEY NARRATIVE TO COMPLY WITH O.R.S. 209-250

Survey for: Mr. C. P. Olson 66-29-3
Rt. 4, Pioneer Rd.
Medford, Oregon

Survey by: Edward A. McGinty, R.S.
Medford, Oregon
March, 1970

Basis of Bearing: Survey No. 3693.

Precedence of Survey:



Surveyed tracts as shown, at request of client.

Survey control, being a portion of previous survey No. 3693, with a slight variation in bearing on the North-South center line of Section 23.

No attempt was made, at this time, to determine the North line of Sec. 23 and East of the North 1/4 cor. The client is aware of this. Instead a witness corner was set.

Monuments found being 5/8 in. iron pins, approx. flush with the surface, with a 1 in. iron pipe and bearing trees at the North 1/4 cor.

Monuments set being 5/8 in. x 24 in. iron pins set approx. flush with the surface.

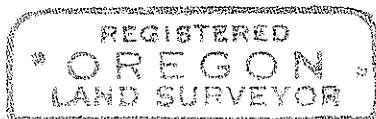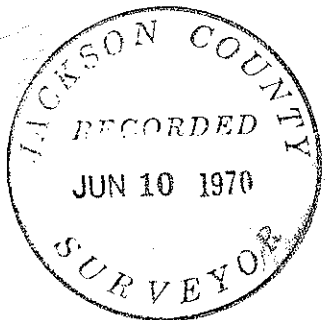

Edward A. McGinty

