

NORTH

LIT
ROAD


FD. 3/4" PIPE

A: 02° 03' 48"
R: 120.24
L: 0.000
C: 0.000

RECORDED SURVEY

NO. 4246

SHIPPED 1' ON 1 1/2"
SMAILED STRIP
N. 25° 25' W. 5.00
N. 45° 55' E. 7.00
200 SQUARES

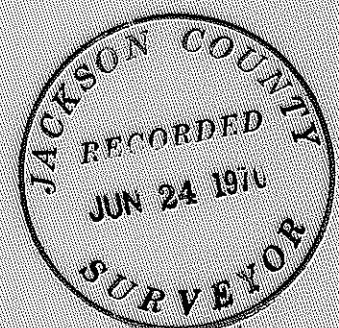

N. 10° 28' 30" E
31.31

N. 31° 28' 30" E 15.00

REGISTERED
OREGON
LAND SURVEYOR

Everett L. Swain

JULY 4 1898
EVERETT L. SWAIN
359

FD. PIPE & BRASS
CAP FOR 1/2" COE
DLC NO. 45

50
SISKIYOU
& CONCRETE
BLVD
PAVEMENT

MAP OF SURVEY

LOCATED IN
DLC NO 45, T 39S R 1E, W.B.M
JACKSON COUNTY OREGON
FOR

OLAN H. SNEED

EVERETT L. SWAIN, RLS ASHLAND, OREGON
BASED ON BEARING & DISTANCE OBSERVATION
CORRECTED BY 1/2" INCH LEAN ROD TAPPED RLS 759
FOUND BY 1/2" INCH 1200 P.W. TAPPED RLS 759

SURVEY NO. - 4252

Survey Narrative to Comply with Paragraph 209.250
Oregon Revised Statutes

SURVEY FOR: Olan H. Sneed
928 Glendale Street
Ashland, Oregon

LOCATION: Situated in Donation Land Claim No. 45, Section 15,
Township 39 South, Range 1 East of the Willamette
Base and Meridian, Jackson County, Oregon.

PURPOSE: To monument and prepare a legal description for the
tract of land as shown on the accompanying map.

PROCEDURE: From control compiled by this office for Recorded
Survey No. 4246, surveyed and monumented the tract
as shown.

May 7, 1970

Everett L. Swain
Professional Land Surveyor
Ashland, Oregon

