

REGISTERED
OREGON
 LAND SURVEYOR
G. H. [Signature]
 JUN 25 1976

MAP OF SURVEY
 LOCATED IN
 D.L.C. NO. 40 T.35S. & T.36 S.
 D.L.C. NO. 45 T.36 S., R.1 W., W.M.
 N.E. 1/4 SEC. 3 T.36 S., R.1 W.
 S.E. 1/4 SEC. 34 T.35 S., R.1 W., W.M.
 JACKSON COUNTY OREGON
FOR
 EAGLE POINT SCHOOL DIST. NO. 9
 J.A. HOFFBUHR, REG. L.S., MEDFORD, OREGON
 SCALE: 1"=100' FEB. 10, 1970
 BASIS OF BEARING R/S NO. 1907
 O = SET 5/8" X 24" IRON REINFORCING PIN
 ● = FD. 5/8" IRON PIN

SURVEY NARRATIVE TO COMPLY WITH PARAGRAPH 209.250
OREGON REVISED STATUTES

SURVEY FOR: Eagle Point School District
Eagle Point, Oregon



LOCATION: Tract situated in the Northeast One Quarter (1/4)
of Section 3, Township 36 South, Range 1 West
and the Southeast One Quarter (1/4) of Section
34, Township 35 South, Range 1 West of the
Willamette Meridian in Jackson County, Oregon.

PURPOSE: To monument the corners of the parcel of land
lying southerly of the North line of Donation
Land Claim No. 45 and describe same. To retrace
Recorded Survey No. 1957 and monument the corners
and describe the parcel lying between the above
described Recorded Survey and the Easterly line
of the Medco Railroad.

PROCEDURE: The controls from previous surveys were used along
with information provided by Recorded Survey Nos. 1307 and 1957.
The corners found from the previous surveys were found to be
reasonably accurate and therefore were used for this survey. The
Medco Railroad right of way controls were located from previous
surveys made by this firm.

Basis of bearings--Recorded Survey No. 1907.

June 12, 1970

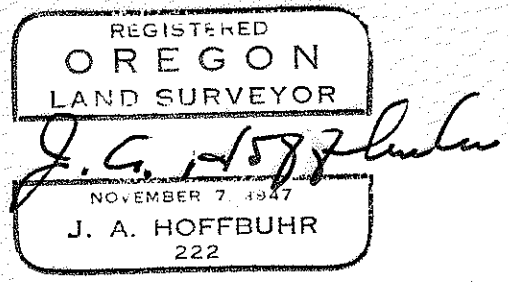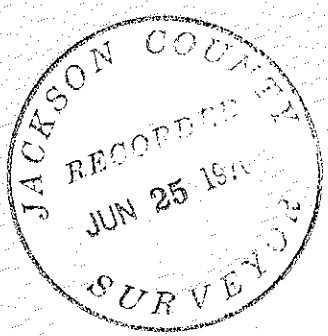

J. A. Hoffbuhr
Registered Land Surveyor