

4290

062V
-A290

Survey Narrative to Comply With Paragraph 209.250

Oregon Revised Statutes


Survey for: Len Osgood
4242 Highway 99 South
Ashland, Oregon 97520

Survey by: Charles H. Hurst, L.S.
28 North Oakdale
Medford, Oregon 97501

Basis of bearing: Recorded Survey No. 3363

Purpose of Survey: To separate the tracts shown.

Procedure: Utilization of Merle Drive R/W survey control.

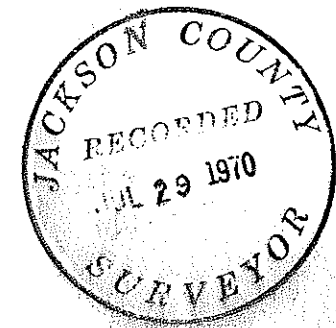


REGISTERED
OREGON
LAND SURVEYOR

Charles H. Hurst

OCTOBER 30, 1959
CHARLES H. HURST
483

APR 18 1970

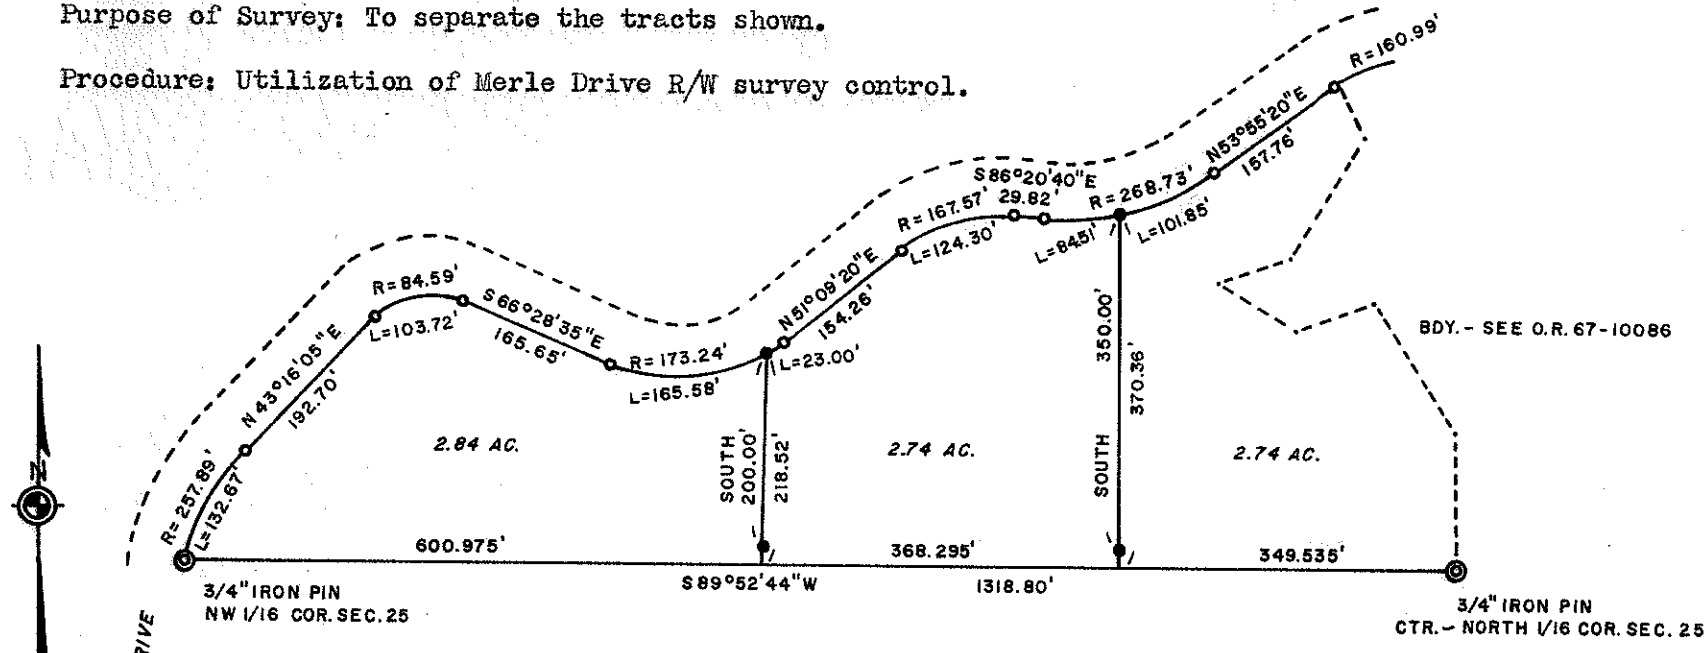

SURVEY IN THE NE 1/4 NW 1/4 SECTION 25
T.39S., R.1E., W.M. JACKSON COUNTY, ORE.

FOR:
LEN OSGOOD

SURVEY BY
CHARLES H. HURST
MEDFORD, OREGON

- LEGEND
- SET 5/8" X 24" IRON PINS
 - 5/8" PINS PER REC. SURVEY NO. 3363
 - ⊙ 3/4" PINS " " " " 3365

-4290