

Office of the Director of Public Works  
 Engineering Division  
 BARNETT ROAD RIGHT OF WAY  
 Murphy Road to 1300' East  
 Scale: 1" = 100' Jan. 23, 1970  
 By: Vernon T. Thorpe, C.E.  
 By: C. Lind McBeth, R.L.S.

PURPOSE OF SURVEY: To establish the center line of Barnett Road between Center Line Station 95+63.08 and Center Line Station 104+22.35

LOCATION OF SURVEY: S 1/2 Sec. 28, T37S, R1W, W.M.

PROCEDURE OF SURVEY: Found PI's as shown in recorded Survey No. 1053. Found spike at Center Line intersection of Barnett Road and Murphy Road. Found southeast corner of Crestbrook Orchard Tract as shown in recorded Survey No. 1209. With this control for the Center Line Barnett Road, pins were set as shown.

BASIS OF BEARINGS: Recorded Survey No. 1053.


RIGHT OF WAY LINES SHOWN ARE PROPOSED ONLY

◆ = NAIL SET

⊙ = 5/8" X 24" I.PIN SET



SCALE 1"=100'

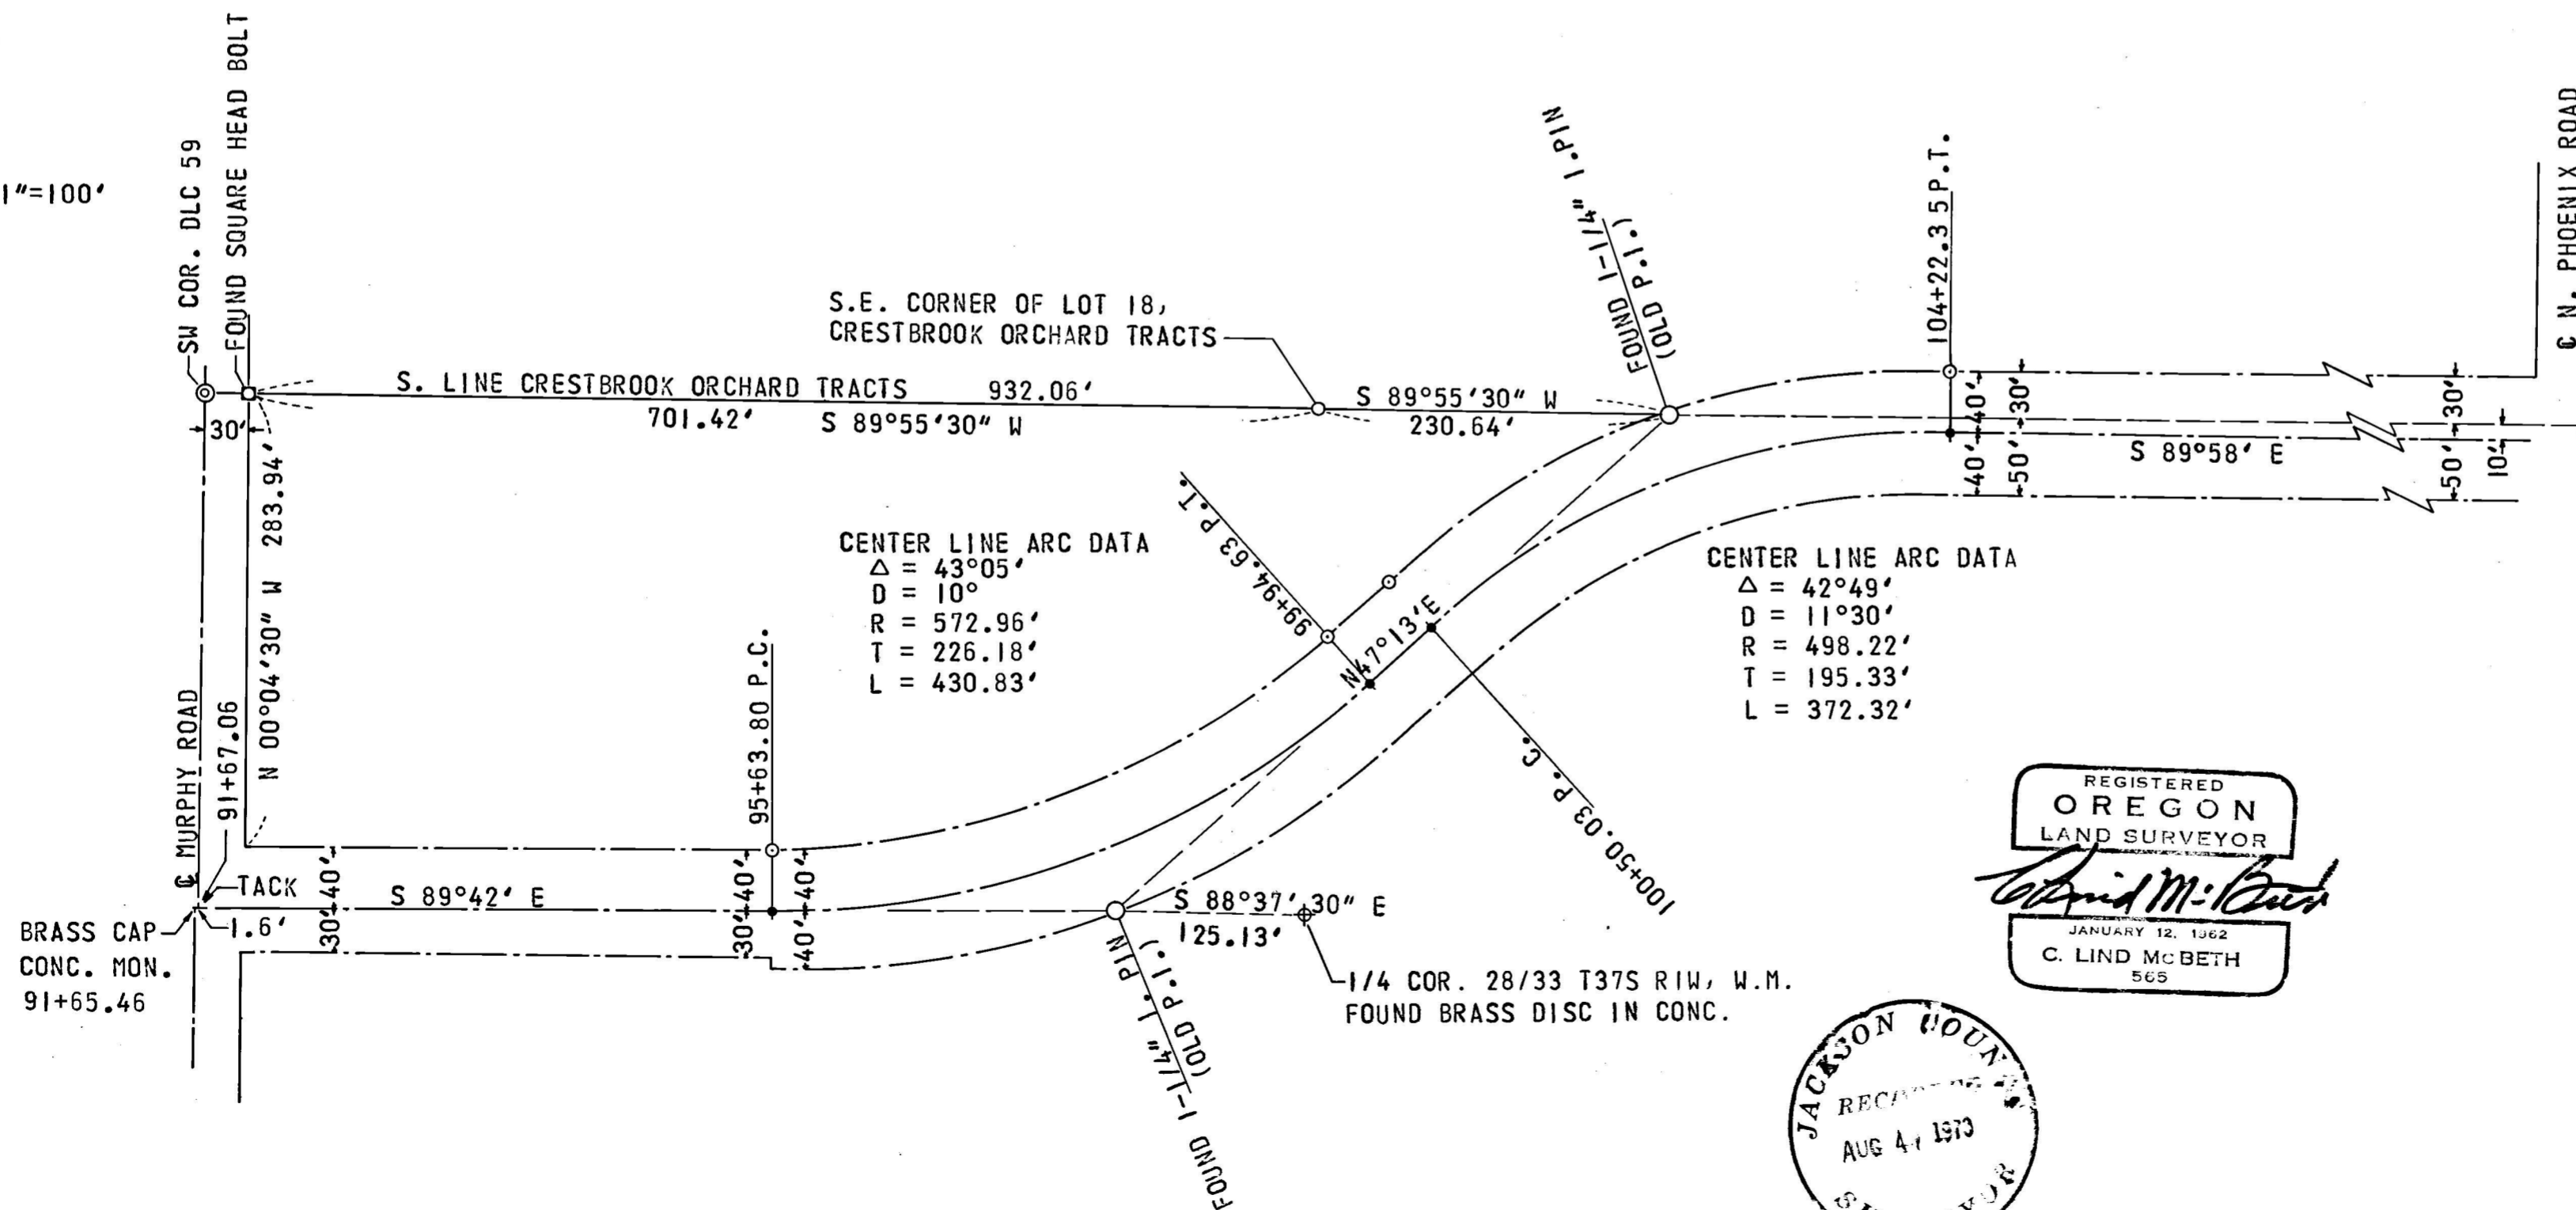

REGISTERED  
 OREGON  
 LAND SURVEYOR  
*C. Lind McBeth*  
 JANUARY 12, 1962  
 C. LIND MCBETH  
 565

JACKSON COUNTY  
 RECORDED  
 AUG 4 1970  
 SURVEYOR

S. E. CORNER CRESTBROOK ORCHARD TRACTS