


SCALE 1" = 100'
 BASIS OF BEARINGS
 RECORDED SURVEY NO. 1450

- LEGEND
- = SET 1/2" x 24" G.I. PIPE
 - = MON. FD. (AS NOTED)
 - - - - - INDICATES LINES NOT ESTABLISHED BY THIS SURVEY

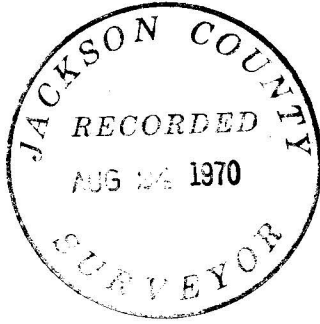

REGISTERED
 OREGON
 LAND SURVEYOR

George Burrell

JULY 10, 1964
 GEORGE R. BURRELL
 638

MAP OF SURVEY

FOR
 SIDNEY DEBOER ASHLAND, OREGON
 OF TRACT
 SITUATE IN THE N.E. 1/4 SEC. 3 TWP. 39S, RIW W.M.
 BY
 GEORGE BURRELL LAND SURVEYOR
 JULY 11, 1970

SURVEY NARRATIVE TO COMPLY WITH O.R.S. 209.250
REVISED BY CHAPTER 555, O.L. 1963

FOR: Sidney DeBoer
253 Cambridge St.
Ashland, Oregon

PURPOSE: To monument the North line of the tract described in O.R. 70-05591 for mortgage purposes, also to monument the East line of the tract described in O.R. 70-06239.

PROCEDURE: The monuments of Recorded Survey No. 1450 were used as control for Holton Road Centerline. This centerline was adopted as the North Boundary of the tract described in Vol. 391, Page 440, D.R., J.C.,O. of which the record calls for the North line of Section 3. Since the clients total ownership is the tract described in Vol. 391, Page 440, D.R., J.C.,O., the true relationship of the road centerline with the section line was not considered in this survey. The fence line near the Southernly boundary of the tract described in a contract of sale (No. C-4167) was monumented for purposes of mutual negotiation only, and therefore does not represent the record at this time.

REGISTERED
OREGON
LAND SURVEYOR

George Burrell

JULY 10, 1964
GEORGE R. BURRELL
638

JACKSON COUNTY
RECORDED
AUG 24 1970
SURVEYOR