

MAP OF SURVEY
 LOCATED IN
 NORTH 1/2 OF SEC. 26 & THE WEST 1/2 OF SEC. 25, T. 35 S., R. 3 W., W.M.
 JACKSON COUNTY OREGON
 FOR
JEROME FITZGERALD

J.A. HOFFBUHR, REG. L.S., MEDFORD, OREGON
 SCALE: 1"=200'
 BASIS OF BEARING - SOLAR OBSERVATION
 SET 5/8" X 24" STEEL REINF. PIN
 REVISED MAY 28, 1968

JACKSON COUNTY
 RECORDED
 SURVEYOR

ORIGINAL
 FILED
 J.A. HOFFBUHR
 SURVEYOR

22+23
 27+26
 FOUND OR BIVAL BEARING TREES
 SET 5/8" X 30" IRON REINF. PIN
 MARKING SECTION CORNER

FOUND 1" GALV. IRON PIPE
 MARKING (1/4) SECTION CORNER

FOUND 3/4" IRON PIPE MARKING
 SECTION CORNER

FOUND OR BIVAL BEARING TREES
 SET 5/8" X 30" IRON REINF. PIN
 MARKING (1/4) SECTION CORNER
 SCRIBED NEW BEARING TREES:
 6" BLACK OAK BEARS N 34° E 18.7'
 6" LAUREL BEARS S 33 1/2° W 12.2'

FOUND QUARTZ STONE
 MARKING (1/4) SECTION
 CORNER

SET 5/8" X 30" IRON REINF. PIN
 MARKING SECTION CORNER
 (SEE NARRATIVE)
 SCRIBED NEW BEARING TREES:
 6" WHITE OAK BEARS N 56 1/2° W 22.0'
 6" BLACK OAK BEARS N 32 1/2° E 30.6'
 6" LAUREL BEARS S 21° E 58.0'
 6" LAUREL BEARS S 72 1/4° W 71.1'

FOUND BRASS DISC
 MARKING SECTION
 CORNER

SET 5/8" X 30" IRON REINF. PIN
 MARKING SINGLE PROPORTIONATE
 (1/4) SECTION CORNER
 SCRIBED NEW BEARING TREES:
 6" BLACK OAK BEARS N 45° W 38.5'
 6" PINE BEARS S 48 3/4° W 16.2'

2677.62' (REC. 2613.6)

2677.62 (REC. 2613.6)

N 89° 56' 00" W (REC. N 89° 30' W)

132
 D

SURVEY NARRATIVE TO COMPLY WITH PARAGRAPH 209.250
OREGON REVISED STATUTES

SURVEY FOR: Jerome Fitzgerald
Holcomb Springs Road
Gold Hill, Oregon



LOCATION: Tract situated in Sections 26 and the West One
Half (1/2) of Section 25, Township 35 South,
Range 3 West, Willamette Meridian, Jackson County,
Oregon.

PURPOSE: To include in additional tracts to Recorded Survey
No. 3715.

PROCEDURE: The control established for Recorded Survey No. 3715
was used for the survey of this additional tract. The tracts were
monumented and described as indicated on the revised map.

Basis of bearings--Solar Observation on Recorded Survey No. 3715.

July 15, 1970

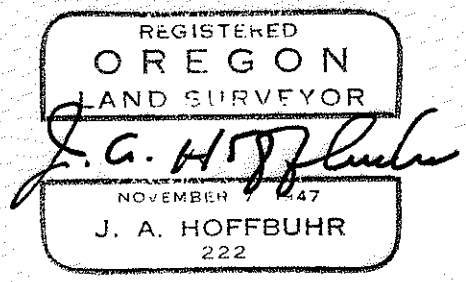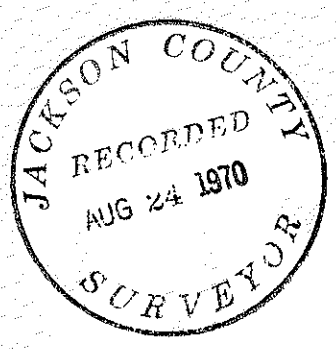

J. A. Hoffbuhr
Registered Land Surveyor