

CERTIFIED RECORD OF LAND CORNER MONUMENTATION

History of original corner establishment
Survey by Charles L. Campbell under contract No 747
dated May 5, 1902.

Original survey states: set an ironstone, 36x20x12
ins. in the ground, struck bedrock, mound of stone
around, for $\frac{1}{4}$ sec. cor. - marked $\frac{1}{4}$ on the W. face;
from which

a pine, 24 ins. diam., bears S 12 $\frac{1}{2}$ W 250 lks.
dist., marked $\frac{1}{4}$ S 35 B T.

No other trees in limits; raised mound of stone,
2 ft. base, 1 $\frac{1}{2}$ ft high, W of Cor. Pits impracticable.

DIAGRAM

T32S R2W WM

S35 $\frac{1}{4}$ S36

Description of corner evidence found:

Found an ironstone, 36x20x12 ins. in the ground, with mound of stone
around, marked $\frac{1}{4}$ on the W. face; from which

a fir 29 ins diam., bears S 12* W 80.0 ft. dist., chopped out
a portion of overgrown face to expose B T. scribes. (Record distance
was 165.0 feet).

Description of monument and accessories I established to perpetuate the
original location of this corner


Set 2" by 30" galvanized iron pipe 24" in the ground alongside
stone monument. I stamped the brass cap

T32S R2W WM
 $\frac{1}{4}$ S
S35+S36
1970
OPE 4906

From which

a fir, 10" in dia. bears S 28*E 9.0 ft. dist.
marked $\frac{1}{4}$ S 36 B.T.

I placed bearing tree tags on all bearing trees facing the monument.
I set a steel fence post 5.0 ft north of monument on line and
attached the penalty and warning sign.

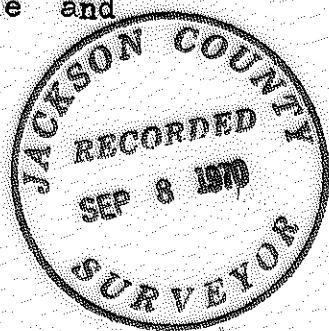

Office of SURVEYOR..... County of JACSON

State of OREGON, I hereby certify that the within instrument was filed in this office
for record on the 8 day of SEPTEMBER, 1970, at 10, a.m., o'clock A.M., (signed)

(COUNTY OFFICIAL)

(DEPUTY)

Jack E. Boyle
C. SURVEYOR



August 25, 1970

CERTIFIED RECORD OF LAND CORNER MONUMENTATION

History of original corner establishment:

The seventh standard parallel south through Range 2 West as surveyed by McKenzie and Eckelson under their contract # 328, dated June 17, 1879.

Original survey states: "Set a post for corner to Sections 33 & 34, from which a:

W. Fir, 8 inches diameter, bears N $42^{\circ}30' E$, 14 links dist..

W. Fir, 18 inches diameter, bears N $18^{\circ}30' W$, 54 links dist..

DIAGRAM
T32S, R2W, W.M.
SEC. COR.

S33 | S34

Description of corner evidence found:

Found a brass cap set by the Cadastral Surveyor, U.S. Bureau of Land Management, 1967, marked as follows:

and from which brass cap a:

Original BT, now a 12" W. Fir, bears N $42\frac{1}{2}' E$, a distance of 14 links. Scribing visible.

14" Fir, a new BT, bears N $19\frac{1}{2}' E$, 37 $\frac{1}{2}$ links, and scribed "SC T32S, R2W S34 BT".

6" W. Fir, a new BT, bears N $37\frac{1}{2}' W$ a distance of 49 links, scribed "SC T32S, R2W, S33 BT".

U.S. Dept. of Interior

SC

T32S, R2W, W.M.

S33 | S34

1967

Cadastral Survey

U.S. Bur. of Land Mgt.

Description of monument and accessories I established to perpetuate the original location of this corner:


Bearing tree tags and appropriate guard sign were placed by U.S.B.L.M. as were above items in description of corner evidence found. No additional monumentation necessary.

Office of SURVEYOR County of Jackson
State of OREGON I hereby certify that the within instrument was filed in this office
for record on the 9 day of SEPTEMBER, 1970, at 11 o'clock A.M. ()

(COUNTY OFFICIAL)

(DEPUTY)

*Jack E. Baile
Co. SURVEYOR*

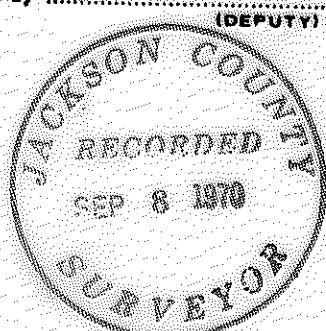

August 25, 1970

CERTIFIED RECORD OF LAND CORNER MONUMENTATION

History of original corner establishment:

West End. of T 32 S., R1 W. W.M.

Survey by Rufus S. Moore under contract No. 475,
dated July 3rd, 1883.

Original survey states: set a basalt stone, 26x12x8
ins. in the ground, for cor. to secs. 19, 24, 25 & 30
on east slope of hill 100 ft below 1/4 sec cor.; marked
with 4 notches on N and 2 notches on S edges, from
which

a fir, 16 ins. diam., bears N63°E., 35 lks. dist
marked T 32 S. R 1 W., S 19 B.T.

a fir 24 ins. diam. bears S 53° E., 20 lks dist
marked T 32 S R 1 W. S 30 B.T.

a fir 25 ins diam., bears S 40° W. 10 lks dist
marked T32 S. R2 W. S 25 B.T.

a fir 35 ins. diam., bears N 41° W. 44 lks dist.
marked T32 S. R 2 W. S 24 B.T.

Description of corner evidence found:

Found a basalt stone 26x12x8 ins., 21 ins. in the ground with
4 notches on North and 2 notches on S edges.

a 20" decayed fir stump bears N63°E., 35 lks dist with
no visible markings, face having been burned out.

a 26 ins. diam. fir stump with face burned out bears S 53°E 20 lks dist.
The decayed remnants of a fir bears S 40° W. 10 lks dist.

a 22" white fir bears N 41° W. 44 lks. face opened and marked
T32 S R 2 W. S 24 B.T. Notes call for a 35" fir in this position.

In addition to the basalt stone, I found a brass cap marked:

T32S, R1 & 2W.W.M.

SEC. COR.

S24 | S19

S25 | S30

1964

CS

**Description of monument and accessories I established to perpetuate the
original location of this corner:**

Moving stone monument aside, I set a 2" by 30 " galvanized iron pipe
with Brass Cap, 24 " in the ground

I stamped the disk

T32S R1-2 W WM

sec. cor.

S24 | S19

S25 | S30

1970

OPE 4906

Incense Cedar 27 ins. in dia.
bears N25°E 46.8 ft. and marked T32 S R 1 W WM. S 19 BT
White Fir 14 ins in dia. bears S 30° E 40.0 ft dist.
marked T32S R1 W S 30 B.T.

D. Fir 31 ins. in dia. bears S24° W 53.0 ft. dist.
marked T32 S R 2 W. S 25 BT

I placed bearing tree tags on all bearing trees facing the monument.
I set a steel fence post 5 ft. North on line with warning and penalty
sign attached.

Office of Surveyor

County of Jackson

State of Oregon

, I hereby certify that the within instrument was filed in this office


for record on the 9 day of September

, 1970, at 11 o'clock A.M., (signed)

(COUNTY OFFICIAL)

by

Hal E. Baugh
C. Surveyor

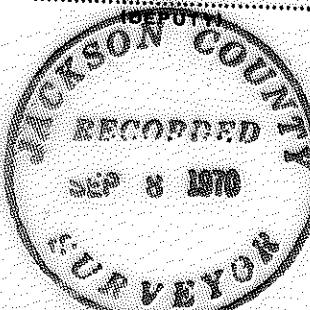

August 25, 1970

CERTIFIED RECORD OF LAND CORNER MONUMENTATION

History of original corner establishment:

West Bdy. of T. 32 S., R. 1 W., W.M.
Survey by Rufus S. Moore under Contract No. 475
dated July 3rd 1883, Survey commenced Nov. 29, 1883.

Original survey states: Set a basalt stone, 20x12x8 ins., 15 ins. in the ground, for cor. to secs. 25, 30, 31, & 36, 100 ft. above stream, marked with 5 notches on N. and 1 notch on S. edges from which-

A Matherone, 6 ins. diam., bears N 53°E 20 lks. dist. marked T32S. R1W. S30 BT.

A live oak, 3 ins. diam., bears S 22°E., 20 lks. dist., marked T32S. R1W., S31, BT.

A live oak, 4 ins. diam., bears S 50°W., 7 lks. marked T32S. R2W. S 36, B.T.

A live oak, 4 ins., diam., bears N 68°W 16lks. dist. marked T32S. R2W. S 25, B.T.

Description of corner evidence found:

Found a basalt stone, 20x12x8 ins., 15 ins. in the ground marked with 5 notches on N. and 1 notch on S. edges

Original hardwood bearing trees destroyed by fire, but identical species have reproduced from the roots of destroyed trees, and are located the called distances and bearings described in original survey notes.

DIAGRAM

T32S. R1 & 2W W.M.

S25	S30
S36	S31

Description of monument and accessories I established to perpetuate the original location of this corner:

Moving original stone aside, I set a 2" by 30" galvanized iron pipe, with Brass Cap, 24" in the ground.

T32S R1-2 W. W.M.

S25	S30
S36	S31

1970

OPE 4906

From the pipe monument I marked four new bearing trees.

A fir, 30" diam., bears S 6°E 68.0 ft dist.
marked T32S., R 1 W., S 31, B.T.

A fir, 40" diam., bears S 25°W 51.5 ft. dist.
marked T32S., R 2 W., S36, B.T.

A fir, 42" diam., bears N 7°W 24.0 ft, dist.
marked T32S., R 2 W., S 25, B.T.

A madrone, 10" diam., bears N 53°E 14.0 ft. dist.
marked T32S., R 1 W., S 30, B.T.

I set a steel fence post 4 feet West of monument on line with warning and penalty sign attached. I placed bearing tree tags on all bearing trees and facing the monument.

Office of SURVEYOR

State of OREGON


for record on the day of SEPTEMBER 1970, at 11 o'clock A.M., (signed)

(COUNTY OFFICIAL)

by

(DEPUTY)

Dale E. Baker
Co. Surveyor

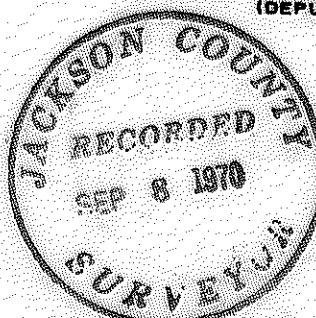

August 26, 1970

CERTIFIED RECORD OF LAND CORNER MONUMENTATION

History of original corner establishment:

The seventh standard parallel South through Range 2 West as surveyed by McKenzie and Eckelson under their contract # 328, dated June 17, 1879.

Original survey states: "Set post for 1/4 Section Corner from which a:

Red Fir, 60 inches diameter, bears N45°E, 2 links dist.

DIAGRAM
T32S, R2W, W.M.
SC
1/4 S 34

Description of corner evidence found:

Found a brass cap set by the Cadastral Surveyor, U. S. Bureau of Land Management, 1967, marked as follows:

and from which brass cap a:

Original 60 inch Fir BT bears N45°E, 6 links, scribing visible but not legible.


8 inch W. Fir, a new bearing tree, scribed "SC 1/4S 34 BT", bears N39°W a distance of 23 links.

U.S. Dept. of Interior
SC
T32S, R2W, W.M.
1/4 S 34
1967

Cadastral Survey
U.S. Bur. of Land Mgt.

Description of monument and accessories | established to perpetuate the original location of this corner

Bearing tree tags and appropriate guard sign were placed by U.S.B.L.M. as were above items in description of corner evidence found. No additional monumentation necessary.

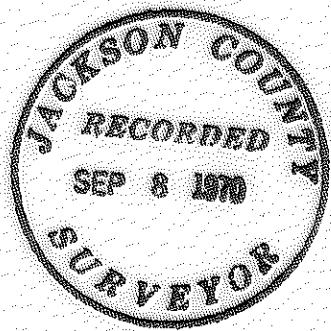

Office of SURVEYOR..... County of JACKSON

State of OREGON, I hereby certify that the within instrument was filed in this office for record on the day of SEPTEMBER, 1970, at 11 o'clock A.M., (signed)

(COUNTY OFFICIAL)

(DEPUTY)

Dick E. Boyle
C. SURVEYOR



August 25, 1970

CERTIFIED RECORD OF LAND CORNER MONUMENTATION

History of original corner establishment:

Survey by Charles L. Campbell under Contract No. 747 dated May 5, 1902.

Original survey states: set an ironstone, 24x12x8 ins. 18 ins. in the ground, for $\frac{1}{4}$ sec. cor., marked $\frac{1}{4}$ on the W. face; from which

a cedar, 18 ins. diam., bears N 5 3/4* E., 54 lks. dist. marked $\frac{1}{4}$ S 34 B.T.

a fir, 28 ins. diam., bears S 79* W., 29 lks. dist., marked $\frac{1}{4}$ S 33 B.T.

DIAGRAM
T32S R2W WM
 $\frac{1}{4}$
S33 • S34

Description of corner evidence found:

Found an ironstone, 24x12x8 ins., 18 ins. in the ground, marked $\frac{1}{4}$ on the W. face; from which

a cedar, 18 ins. diam. bears N 5 3/4* E., 54 lks dist. with face exposed and marked $\frac{1}{4}$ S 34 B.T.

a fir, 33 ins diam. bears S 79* W., 29 lks. dist. face grown over end formed large pitch burl.

Description of monument and accessories I established to perpetuate the original location of this corner

Moved stone aside and set a 2" by 30" galvanized iron pipe, with a brass cap, 24" in the ground.

I stamped the disk

T32S R 2W WM

$\frac{1}{4}$
S33 • S34
1970



OPE 4906

I placed bearing tree tags on all bearing trees facing the monument. I set a steel fence post 5 ft. north of monument on line with warning and penalty sign attached.

Office of... SURVEYOR..... County of... JACKSON.....

State of... OREGON....., I hereby certify that the within instrument was filed in this office for record on the ...S... day of... SEPTEMBER, 1970, at... 11... o'clock A.M. (signed)

Jack E. Foyde
Co. SURVEYOR..... by.....
(DEPUTY)

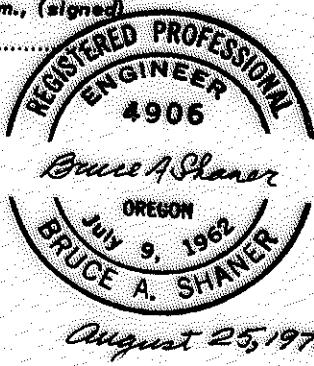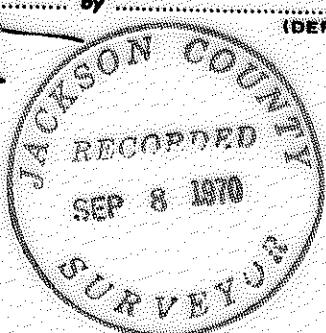

August 25, 1970

CERTIFIED RECORD OF LAND CORNER MONUMENTATION

4004

History of original corner establishment:

Survey by Charles L. Campbell under Contract No. 747
dated May 5 1902.

Original survey states: set a basalt stone, 36x15x4
ins., 20 ins in the ground with mound a stone around,
for cor of secs. 25, 26, 35, 36, marked with 1 notch on
S. and E. edges; from which

DIAGRAM

T32S	R 2W	WM
Sec. Cor		
S26	S25	
S35	S36	

A fir 20 ins. diam. bears N 10 $\frac{1}{2}$ E, 68 lks. dist.
marked T32S R2W S25 B.T.

A fir 38 ins. diam. bears S11 $\frac{1}{2}$ E, 68 lks. dist.
marked T32S R2W S36 B.T.

A fir, 36 ins. diam., bears S49 $\frac{1}{2}$ W., 25lks. dist.
marked T32 S R 2 W S35 B.T.

A fir, 20 ins. diam. bears N28 $\frac{1}{2}$ W 73lks. dist.
marked T32 S R 2 W S 26 B.T.

Description of corner evidence found:

A basalt stone, 36x14x4 ins., 20 ins. in the ground with a mound of
stone around, marked with 1 notch on S. and E. edges; from which,

A fir 22" bears N10 $\frac{1}{2}$ E 37.0 ft. with closed face.

A fir 36 ins. stump with face open and in good condition bears
S11 $\frac{1}{2}$ E 8.0 ft. marked T32S R2 W S36 B.T.

A fir 27 ins. diam. bears S 49 $\frac{1}{2}$ W 14.0 ft dist. with face opened.
marked T32 S R 2 W S 35 B .T.

A fir, 25 ins. diam. with closed face bears N28 $\frac{1}{2}$ W 46.6 ft dist.

Description of monument and accessories I established to perpetuate the
original location of this corner:

Moved stone aside and set a 2" by 30" galvanized iron pipe, with
brass cap, 24" in the ground.

T 32 S R 2 W WM

Sec. Cor.


S26 | S25

S35 | S36

1970

OPE 4906

I placed bearing tree tags on all bearing trees facing the monument.
I set a steel fence post 5 feet West of monument on line and attached
penalty and warning sign.

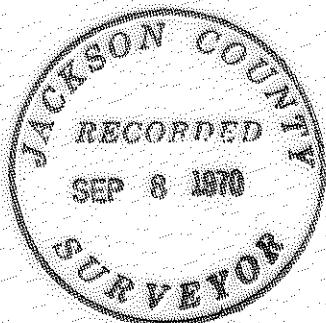


Office of SURVEYOR County of JACKSON
State of OREGON I hereby certify that the within instrument was filed in this office
for record on the 8 day of SEPTEMBER, 1970, at 11 o'clock A.M., (signed)

(COUNTY OFFICIAL)

(DEPUTY)

Jack E. Taylor
Co. SURVEYOR

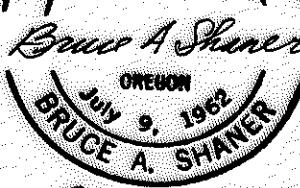*August 25, 1970*

CERTIFIED RECORD OF LAND CORNER MONUMENTATION


4004

History of original corner establishment:

The seventh standard parallel south through Range 2 West as surveyed by McKenzie and Eckelson under their contract # 328, dated June 17, 1879.

Original survey notes state; "Set a post for corner to Sections 35 & 36, from which:

A Laurel, 18 inches diameter, bears N50°E, 62 links dist..
A Fir, 20 inches diameter, bears N60°W, 140 links distant.

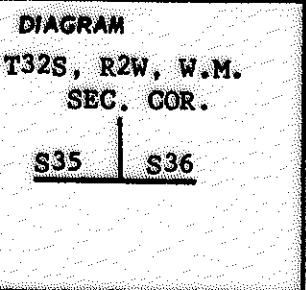

Description of corner evidence found:

Found a brass cap set by the Cadastral Surveyor, U.S. Bureau of Land Management, 1967, marked as follows:

and from which brass cap a:

Original Fir BT, now 30 inches diameter, with face opened and scribes visible, bears N60°W, 140 links distant.

8 inch diameter Fir, a new BT scribed "T32S, R2W, S35 BT", bears N33°W, 38 links distant.

12 inch diameter Fir, a new BT scribed "T32S R2W S36BT", bears N91°E a distance of 88 links.

U.S. Dept. of Interior

SC

T32S, R2W, W.M.

S35 | S36

1967

Cadastral Survey


U.S. Bur. of Land Mgt.

Description of monument and accessories established to perpetuate the original location of this corner:

Bearing tree tags and appropriate guard sign were placed by U.S.B.L.M. as were above items in description of corner evidence found. No additional monumentation necessary.

NOTE:

The same closing corner of Sections 35 & 36 as established by Jackson County Surveyor Boyden in 1962(see Jackson County Survey No. 1999) by intersection of lines, is approximately 290 feet East of the above true corner as monumented by the Cadastral Surveyor. In addition, the closing corner of Sections 1 & 2 as re-established by Boyden is 8 feet southeast of above true corner, whereas that re-established by the Cadastral Surveyor is approximately 290 feet West.

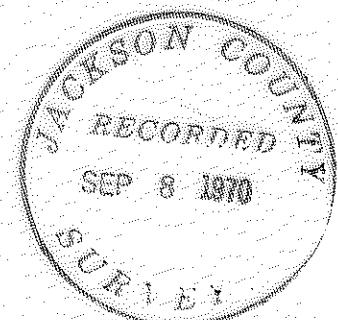

Office of SURVEYOR..... County of JACKSON
State of OREGON..... I hereby certify that the within instrument was filed in this office
by
(DEPUTY)
John E. Boyle
C. SURVEYOR



August 25, 1970

CERTIFIED RECORD OF LAND CORNER MONUMENTATION

History of original corner establishment:

West Bdy. of T.32S., R. 1 W. W.M.

Survey by Rufus S. Moore under contract No 475

dated July 3rd, 1883, Survey commenced Nov. 29, 1883.

Original survey states: Set a basalt stone, 18x12x8 ins., 12 ins. in the ground, for $\frac{1}{4}$ sec. cor. marked $\frac{1}{4}$ on W. face, 100 ft above last sec. cor., on E slope of hill; from which

A yew, 10ins. diam., bears N85°E 15 lks. dist.
marked $\frac{1}{4}$ S B.T.

A fir, 40 ins. diam., bears S 18°W 57 lks. dist.
marked $\frac{1}{4}$ S B.T.

DIAGRAM

T32S.R1 & 2W. W.M.

$\frac{1}{4}$
S25 • S30

Description of corner evidence found:

Found basalt stone run over by bulldozer and broken into several pieces. After re-assembling stone is 18x12x8 ins., 12 ins. in the ground for $\frac{1}{4}$ sec. cor., marked $\frac{1}{4}$ on west face.

from which the remnants of burned and decayed 40 in. fir bears S 18° W., 57 lks dist. No evidence of original face or scribing.

Remnants of 10 ins. yew found approx. 100 ft. easterly where it had been pushed by bulldozer. No evidence of original face or scribing found.

Description of monument and accessories I established to perpetuate the original location of this corner:

Moving original stone aside, I set a 2" by 30" galvanized iron pipe, with Brass Cap, 24" in ground.

I stamped the disk

T32S R1-2W WM

$\frac{1}{4}$ S

S25 • S30

1970


OPE 4906

From the pipe monument, I marked two new bearing trees.

A fir, 14" diam. bears N27 $\frac{1}{2}$ *E 22.7 ft. dist.
marked $\frac{1}{4}$ S 30 B.T.

A fir, 16" diam. bears S73 $\frac{1}{2}$ *W 27.0 ft. dist.
marked $\frac{1}{4}$ S 25 B.T.

I placed bearing tree tags on all bearing trees facing the monument. I set a steel fence post 5 ft. South on line with warning and penalty sign attached.

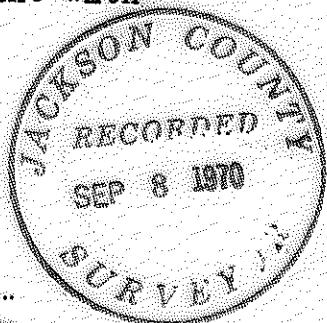

Office of SURVEYOR, County of JACKSON

State of OREGON, I hereby certify that the within instrument was filed in this office
for record on the Sept 8 day of 1970, at 11 o'clock A.M., (signed)

(COUNTY OFFICIAL)

(DEPUTY)

Jack E. Becker
Co. SURVEYOR



August 25, 1970

4544

CERTIFIED RECORD OF LAND CORNER MONUMENTATION

History of original corner establishment:

Survey by Charles L. Campbell under Contract No. 747 dated May 5, 1902.

Original survey states: Set an ironstone, 28x20x10 ins. in the ground, for $\frac{1}{4}$ sec. cor., marked $\frac{1}{4}$ on N. face; from which

A sugar pine, 60 ins. diam., bears S 1°W 45 lks. dist. marked $\frac{1}{4}$ S 36 B.T.

A fir, 30 ins. diam., bears N24°W., 40 lks. dist. marked $\frac{1}{4}$ S 25 B.T.

DIAGRAM

T32S R2W WM

$\frac{1}{4}$
S25
S36

Description of corner evidence found:

Found 28x20x10 ins. stone, 21 ins. in the ground with $\frac{1}{4}$ marked on North face, from which

A sugar pine, 60 ins. in diam., decayed stub remaining with bottom of old face showing. Face pulled out and gone with tree. Face bears S 1°W 25.5 ft. from stone.(Record was 29.7 feet.)

A fir, 37 ins. in diam. bears N24°W with face exposed and marked $\frac{1}{4}$ S 25 BT . a distance of 24.0 feet from stone.s(Record was 26.4 feet.)

Description of monument and accessories I established to perpetuate the original location of this corner.

Moved stone aside and set a 2" by 30" galvanized iron pipe, with Brass Cap, 24" in the ground.

I stamped the disk

T32S R2W WM

$\frac{1}{4}$
S25
S36
1970
OPE 4906

In place of sugar pine, I marked 15" fir, which bears S 52° W 18.0 ft. dist. and scribed $\frac{1}{4}$ S 36 B.T.



I placed bearing tree tags on all bearing trees facing the monument. I set a steel fence post approx. 5 ft west of monument on line with warning and penalty sign attached.

Office of SURVEYOR County of JACKSON

State of OREGON, I hereby certify that the within instrument was filed in this office for record on the 9 day of SEPTEMBER, 1970, at 11 o'clock A.M., (signed)

(COUNTY OFFICIAL)

Jack E. Boyden
Co. SURVEYOR

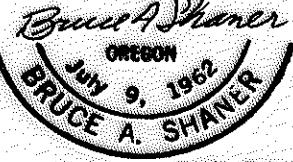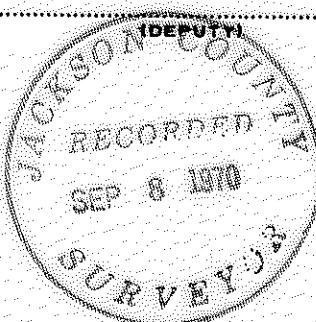

August 25, 1970

1344

CERTIFIED RECORD OF LAND CORNER MONUMENTATION

History of original corner establishment:

/Seventh

The standard parallel South through Range 2 West as surveyed by McKenzie and Eckelson under their contract # 328, dated June 17, 1879.

Original survey states; "Set post for quarter section corner, from which a W. Fir, 30 inch diameter, bears N8°40'E, 6 links distant."

DIAGRAM

T32S, R2W, W.M.
SC
1/4S
S 35

Description of corner evidence found:

Found a brass cap set by the Cadastral Surveyor, U.S. Bureau of Land Management, 1967, marked as follows:

and from which brass cap a:

10" W. Fir, a new bearing tree, scribed "SC 1/4S 35 BT", bears N20°W a distance of 21 links.

18" Cedar, a new bearing tree, scribed "SC 1/4S 35 BT", bears N67°E a distance of 68 links.

U.S. Dept. of Interior
SC
1/4 S 35
1967

Cadastral Survey
U.S. Bur. of Land Mgt.

Description of monument and accessories I established to perpetuate the original location of this corner



Bearing tree tags and appropriate guard sign were placed by U.S.B.L.M. as were above items in description of corner evidence found. No additional monumentation necessary.

Office of SURVEYOR..... County of JACKSON.....

State of OREGON..... I hereby certify that the within instrument was filed in this office for record on the 8 day of SEPTEMBER, 1970, at 11 o'clock A.M., (signed)

Jack E. Shaefer..... by (DEPUTY)

Co. SURVEYOR

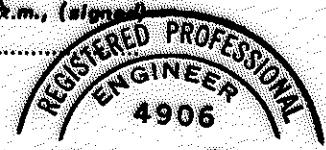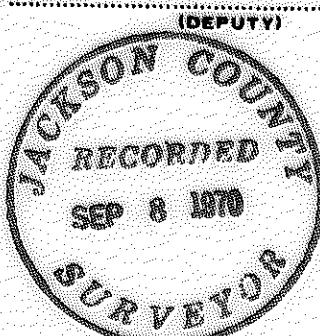

- 4444

CERTIFIED RECORD OF LAND CORNER MONUMENTATION

History of original corner establishment:

The seventh standard parallel South through Range 2 West as surveyed by McKenzie and Eckelson under their contract # 328 , dated June 17, 1879.

Original survey states: "Set a post corner to Sections 34 & 35, from which a:

W. Fir, 20 inches diameter, bears N50°15'W, 39 links dist.. Laurel, 8 inches diameter, bears N15°40'E, 38 links dist..

DIAGRAM
T32S, R2W, W.M.
Sec. Cor.
S34 | S35

Description of corner evidence found:

Found a brass cap set by the Cadastral Surveyor, U.S. Bureau of Land Management, 1967, marked as follows:

and from which brass cap a:

Original 20" W. Fir BT, now a 30" decayed snag with original scribe visible, bears N50 3/4°W, 39 links distant.

29" Fir, a new bearing tree, scribed "SC T32S R2W S34 BT", bears N63°W a distance of 71 links.

30 " Fir, a new bearing tree, scribed "SC T32S R2W S35 BT", bears N80°E a distance of 74 links.

U.S. Dept. of Interior

SC

T32S, R2W, W.M.

S34 | S35

1967

Cadastral Survey

U.S. Bur. of Land Mgt.

Description of monument and accessories I established to perpetuate the original location of this corner:


Bearing tree tags and appropriate guard sign were placed by U.S.B.L.M. as were above items in description of corner evidence found. No additional monumentation necessary.


(COUNTY OFFICIAL)

(DEPUTY)

Dave E. Boyd
Co. Surveyor

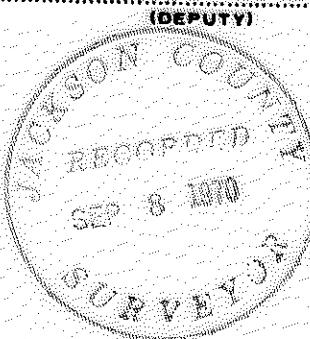

August 25, 1970