

MAP OF SURVEY  
LOCATED IN  
S.W. 1/4 AND THE S. 1/2 OF THE N. 1/2 OF SEC. 17, T. 33 S., R. 2 E., W.M.  
JACKSON COUNTY OREGON  
FOR  
MARK A. SHIPLEY  
J. A. HOFFBUHR, REG. L.S., MEDFORD, OREGON  
SCALE: 1"=100'  
BASIS OF BEARING - R/S NO. 2885  
SET 5/8" X 24" IRON REINFORCING PIN  
REVISED MARCH 11, 1968  
REVISED AUGUST 12, 1968

J. C. Hoffbuh

SURVEY NARRATIVE TO COMPLY WITH PARAGRAPH 209.250  
OREGON REVISED STATUTES

SURVEY FOR: Mark A. Shipley  
Star Route Box 230  
Prospect, Oregon 97536



LOCATION: Tract situated in Section 17, Township 33 South,  
Range 2 East, Willamette Meridian, Jackson County,  
Oregon.

PURPOSE: To monument the corners of the tracts shown on  
the attached copy.

PROCEDURE: The tracts were surveyed and described as indicated  
on the attached map. The lines were positioned by the client and  
the controls of Evergreen Meadows Subdivision and Recorded Survey  
Nos. 2885, 3542, 3929 were used for this survey.

The basis of bearings was a set of Solar Observations taken  
on the initial survey, Recorded Survey No. 2885, (later revised by  
Recorded Survey No. 3542).

September 16, 1970

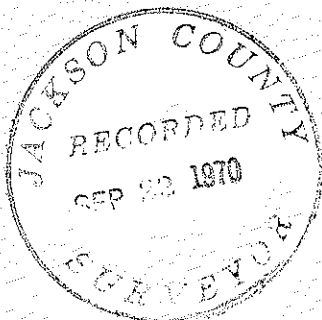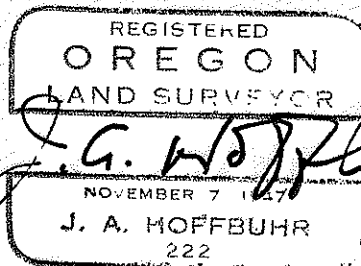

J. A. Hoffbuhr  
Registered Land Surveyor