
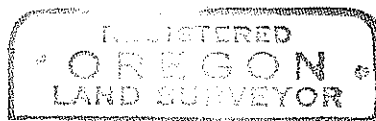


SURVEY IN CITY OF JACKSONVILLE, ORE.
 N.W. 1/4 SEC. 32, T.37S., R. 2W., W.M.

FOR
D. LITTMAN & R. BRETNOR
 70 - 16

BY EDWARD MC GINTY
 MEDFORD, OREGON
 O = SET 5/8" X 24" IRON PIN

SCALE: 1" = 50'
 JULY 1970
 ● = FD. 5/8" I. PIN

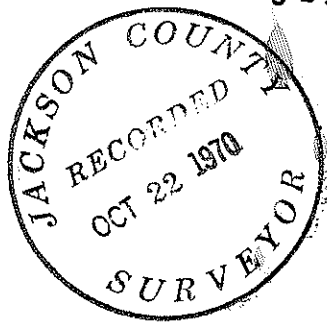

Edward A. McGinty
 JULY 19, 1970
 EDWARD A. MCGINTY
 301

Survey No. 4387

SURVEY NARRATIVE TO COMPLY WITH O.R.S. 209-250

Survey for: Don Littman & R. Bretnor
PO Box 566
Jacksonville, Oregon

Survey by: Edward A. McGinty, R. S.
Medford, Oregon
July 1970

Basis of Bearing: Survey No. 1783

Precedence of Survey:

Surveyed tract as shown, found nail set for center line of Main St. and 3rd St. This was replaced with 5/8 in. x 24 in. iron pin. At point (A) found 3/4 inch iron pin and at points (B) and (C) found 5/8 in. iron pins. Found 5/8 in. iron pins, being center line monuments.

