

# MAP OF SURVEY

(Boundary Line Agreement)

Situated in the NE 1/4, NE 1/4,  
Section 14, & NW 1/4, NW 1/4,  
Section 13, T39S, R3W, W.M.  
Jackson County, Oregon

FOR

WAYNE REAVIS

Jack L. Couch RLS No. 685  
Medford, Oregon Nov. 11, 1970  
Basis of Bearing R/S No. 3612

Survey No. 4408


Survey Narrative to comply with O.R.S. 209.250

FOR: Wayne Reavis  
Route 2 Box 40  
Little Applegate Road  
Jacksonville, Oregon

PURPOSE: To survey and describe monuments as set by owners at fence corners for Boundary Line Agreement between Wayne Reavis and Kenneth Howard.

PROCEDURE: Found section corner common to Sections 11, 12 13, and 14 as shown in Recorded Survey No. 3612, also found 5/8 inch iron pin as mentioned in reference to said section corner. From said section corner tied 1 1/2 inch by 1 1/2 inch Angle Iron at southwest corner of fence, and tied 5/8 inch iron pin at the northeast fence corner as set by adjoining owners. Inversed between Angle Iron and Iron Pin to establish balance of Boundary Line Agreement.

November 11, 1970

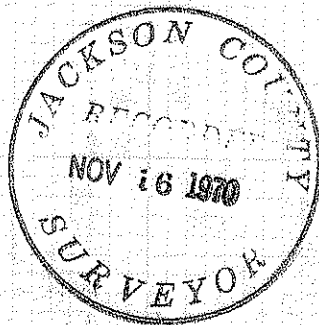

Jack L. Couch  
Registered Land Surveyor

