

*J. A. Hoffbuhr*  
J. A. HOFFBUHR

MAP OF SURVEY  
LOCATED IN  
S.W. 1/4 OF SECTION 26, T. 38 S., R. 1 W., W.M.  
JACKSON COUNTY OREGON  
FOR  
**C. O. WEBBER**

J. A. HOFFBUHR, REG. L.S., MEDFORD, OREGON  
SCALE: 1" = 100' MAY 15, 1969  
BASIS OF BEARING - R/S NO. 3658  
5/8" X 24" IRON REINFORCING PIN

4419


SURVEY NARRATIVE TO COMPLY WITH PARAGRAPH 209.250  
OREGON REVISED STATUTES

SURVEY FOR: Calvin Webber  
6731 Wagner Creek Road  
Talent, Oregon

LOCATION: Tract situate in the Southwest One Quarter (1/4)  
of Section 26, Township 38 South, Range 1 West,  
Willamette Meridian, Jackson County, Oregon.

PURPOSE: To correct the tie distances shown on Recorded  
Survey No. 3997. The tie distances have been corrected on the attached  
map and are as follows: The Northeast Corner of Donation Land Claim  
No. 63 bears North 4050.99 and East 610.56 feet from the Northwest  
Corner of this tract.

November 27, 1970

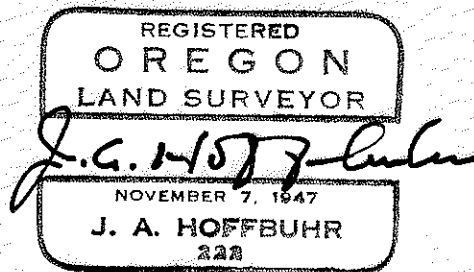

J. A. Hoffbuhr  
Registered Land Surveyor

