

4431



BASIS OF BRG. SURVEY 3606

NW 1/4 SW 1/4

16° C.L.
Δ = 38°07'20"
T = 123.73'
L = 238.26'

N 36°21'15" E
340.19'

6° C.R.
Δ = 19°31'55"
T = 164.36'
L = 325.53'


30' 30"

N 16°49'20" E
635.24'

SE 1/4 SE 1/4

SW 1/4 SW 1/4

SURVEY SITUATE IN THE SE 1/4 SE 1/4 OF SEC. 35 & THE W 1/2 SW 1/4 OF SEC. 36, T. 37 S., R. 4 W., W.M. JACKSON COUNTY, OREGON

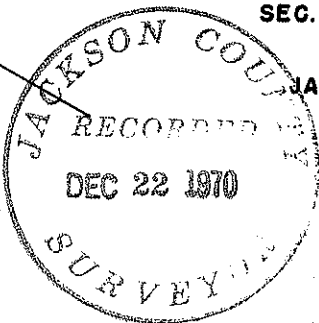

FOR W. H. PITTOCK

SCALE 1" = 200'

2° C.R.
Δ = 7°38'50"
T = 191.46'
L = 382.08'

FD. 5/8" R/W PINS - END OF HUMBURG CRK. COUNTY RD.

N 9°10'28" E
354.36'

WEST 87.06'

NORTH 146.64'

35 1/36
2 1

FD. SEC. COR. 2" IRON PIPE

SURVEY BY CHARLES H. HURST MEDFORD, OREGON

LEGEND

- SET 5/8" X 24" IRON PINS*
- ← INTERMITTANT STREAMS

REGISTERED OREGON LAND SURVEYOR

Charles H. Hurst

OCTOBER 30, 1959 CHARLES H. HURST 483

NOV 2 1970

* R.P.'S AT R/W R.I.'S

4431

SURVEY NARRATIVE TO COMPLY WITH PARAGRAPH 209.250

OREGON REVISED STATUTES

Survey for: William H. Pittock
 Route 1, Box 41
 Applegate, Oregon 97530

Survey by : Charles H. Hurst, L.S.
 28 North Oakdale
 Medford, Oregon 97501

Bearing : Based on the meridian for Recorded Survey No. 3606


Purpose : To define the location of a private roadway.

PROCEDURE

Extended the alignment of Humbug Creek County Road from its terminus Northerly with the possibility that at some future date said location might be subject to the creation of a public roadway.

Tangents measured with a geodimeter.

November 2, 1970

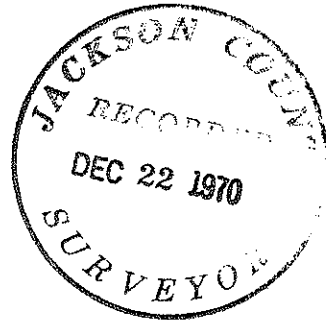

Charles H. Hurst

