

FOUND 1" IRON ROD, 12" DEEP


FD. 1/2" PIPES (SEE 300.00)

FOUND 3/4" PIPE 10" DEEP

S.W. COR. DLC NO. 39 IOWA

FOUND 5 1/2" x 6" SANDSTONE 15" DEEP AT INTERSECTION OF SISKIYOU BLVD. & ALIDA STREET.

NORTH

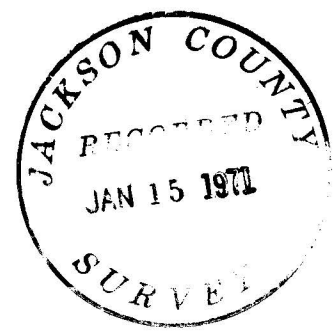

FOUND 1/2" SQ. IRON BAR, 6" DEEP PER CITY OF ASHLAND REFERENCES

REGISTERED
OREGON
LAND SURVEYOR

Everett L. Swain

JULY 6, 1966
EVERETT L. SWAIN
759

FOUND BOLT PER CITY OF ASHLAND REFERENCES. SET MON. AS SHOWN

FOUND 3/4" PIPE 15" DEEP

LEGEND

- FOUND MON. AS SHOWN
- FOUND "CITY OF ASHLAND" BRONZE DISK IN MON. CASE
- SET 2" G.I. PIPE & 3" BRONZE DISK IN MON. CASE

MAP OF SURVEY

LOCATED IN
DLC NO. 39, SEC. 9 TWP. 39S. E. 1E., W. 1/4M.
JACKSON COUNTY OREGON
FOR

"CITY OF ASHLAND"

EVERETT L. SWAIN, R.L.S.
SCALE 1" = 100'
BASIS OF BEARING

ASHLAND, OREGON
JANUARY 10, 1971
U.S.C. & G.S. TRUE BEARING

SURVEY NO. 4442

Survey Narrative to Comply with Paragraph 209.250
Oregon Revised Statutes

SURVEY FOR: City of Ashland
City Hall
Ashland, Oregon

LOCATION: Situated in Donation Land Claim No. 39, Section 9,
Township 39 South, Range 1 East of the Willamette
Base and Meridian, Jackson County, Oregon.

PURPOSE: To monument the centerline intersection for the streets
shown on the accompanying map.

PROCEDURE: From survey information compiled by this office, proceeded
to monument the centerline intersections as shown on
the accompanying map. See recorded survey No. 4279.

Everett L. Swain
Professional Land Surveyor
Ashland, Oregon

