

MAP OF SURVEY
 LOCATED IN
 SEC 36 T36S, R3W, W.M.
 JACKSON COUNTY OREGON
 FOR
 HAZEL HOLIFIELD

J. A. HOFFBUHR, REG. L. S., MEDFORD, OREGON
 SCALE: 1" = 100'
 BASIS OF BEARING - R.S. 957
 * SET 5/8" X 24" IRON REINFORCING PIN

SURVEY NARRATIVE TO COMPLY WITH PARAGRAPH 209.250
OREGON REVISED STATUTES

SURVEY FOR: Mrs. Hazel Holifield
6234 Old Stage Road
Central Point, Oregon


LOCATION: Tract situated in Section 36, Township 36 South,
Range 3 West, Willamette Meridian, Jackson County,
Oregon.

PURPOSE: To monument the portion of the tract within Recorded
Survey No. 957 that lies Southerly of the existing
fence line as shown and provide legal descriptions
of same.

PROCEDURE: The Southeast Corner of Government Lot No. 4 was
found as shown in addition to the 3/4 inch iron bolts as indicated
on the map.

Basis of bearings--Recorded Survey No. 957.

December 28, 1970

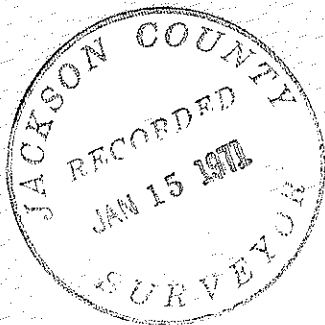

J. A. Hoffbuhr
Registered Land Surveyor

