


PLAT


of

Survey in the NE 1/4 of the NW 1/4 of Sec. 21,
 T. 35 S., R. 4 W., W. M., Jackson County, Oregon
 Feb. 1, 1971
 Scale 1" = 100'

For: MR. DALE BOYD
 1408 N. E. 10th St.
 Grants Pass, Oregon

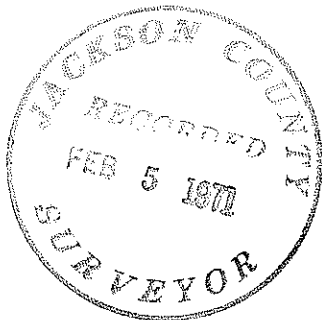

Claude E. Masters

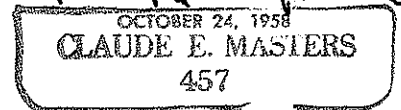

SURVEY NO. 4460

SURVEY NARRATIVE to comply with Paragraph 209.250, Oregon Revised Statutes.

SURVEY FOR: MR. DALE BOYD
1408 N. E. 10th St.
Grants Pass, Oregon

PURPOSE: To survey and monument 2 one acre parcels in the Northeast 1/4 of the Northwest 1/4 of Section 21, Township 35 South, Range 4 West, Willamette Meridian, Jackson County, Oregon.

PROCEDURE: Found the North and South 1/4 corners of Section 21 and established the North-South center-line.

Set Iron Pins to monument parcels, as shown, using bearings and road monuments per Survey 3150 by R.S. 222.

