


4463

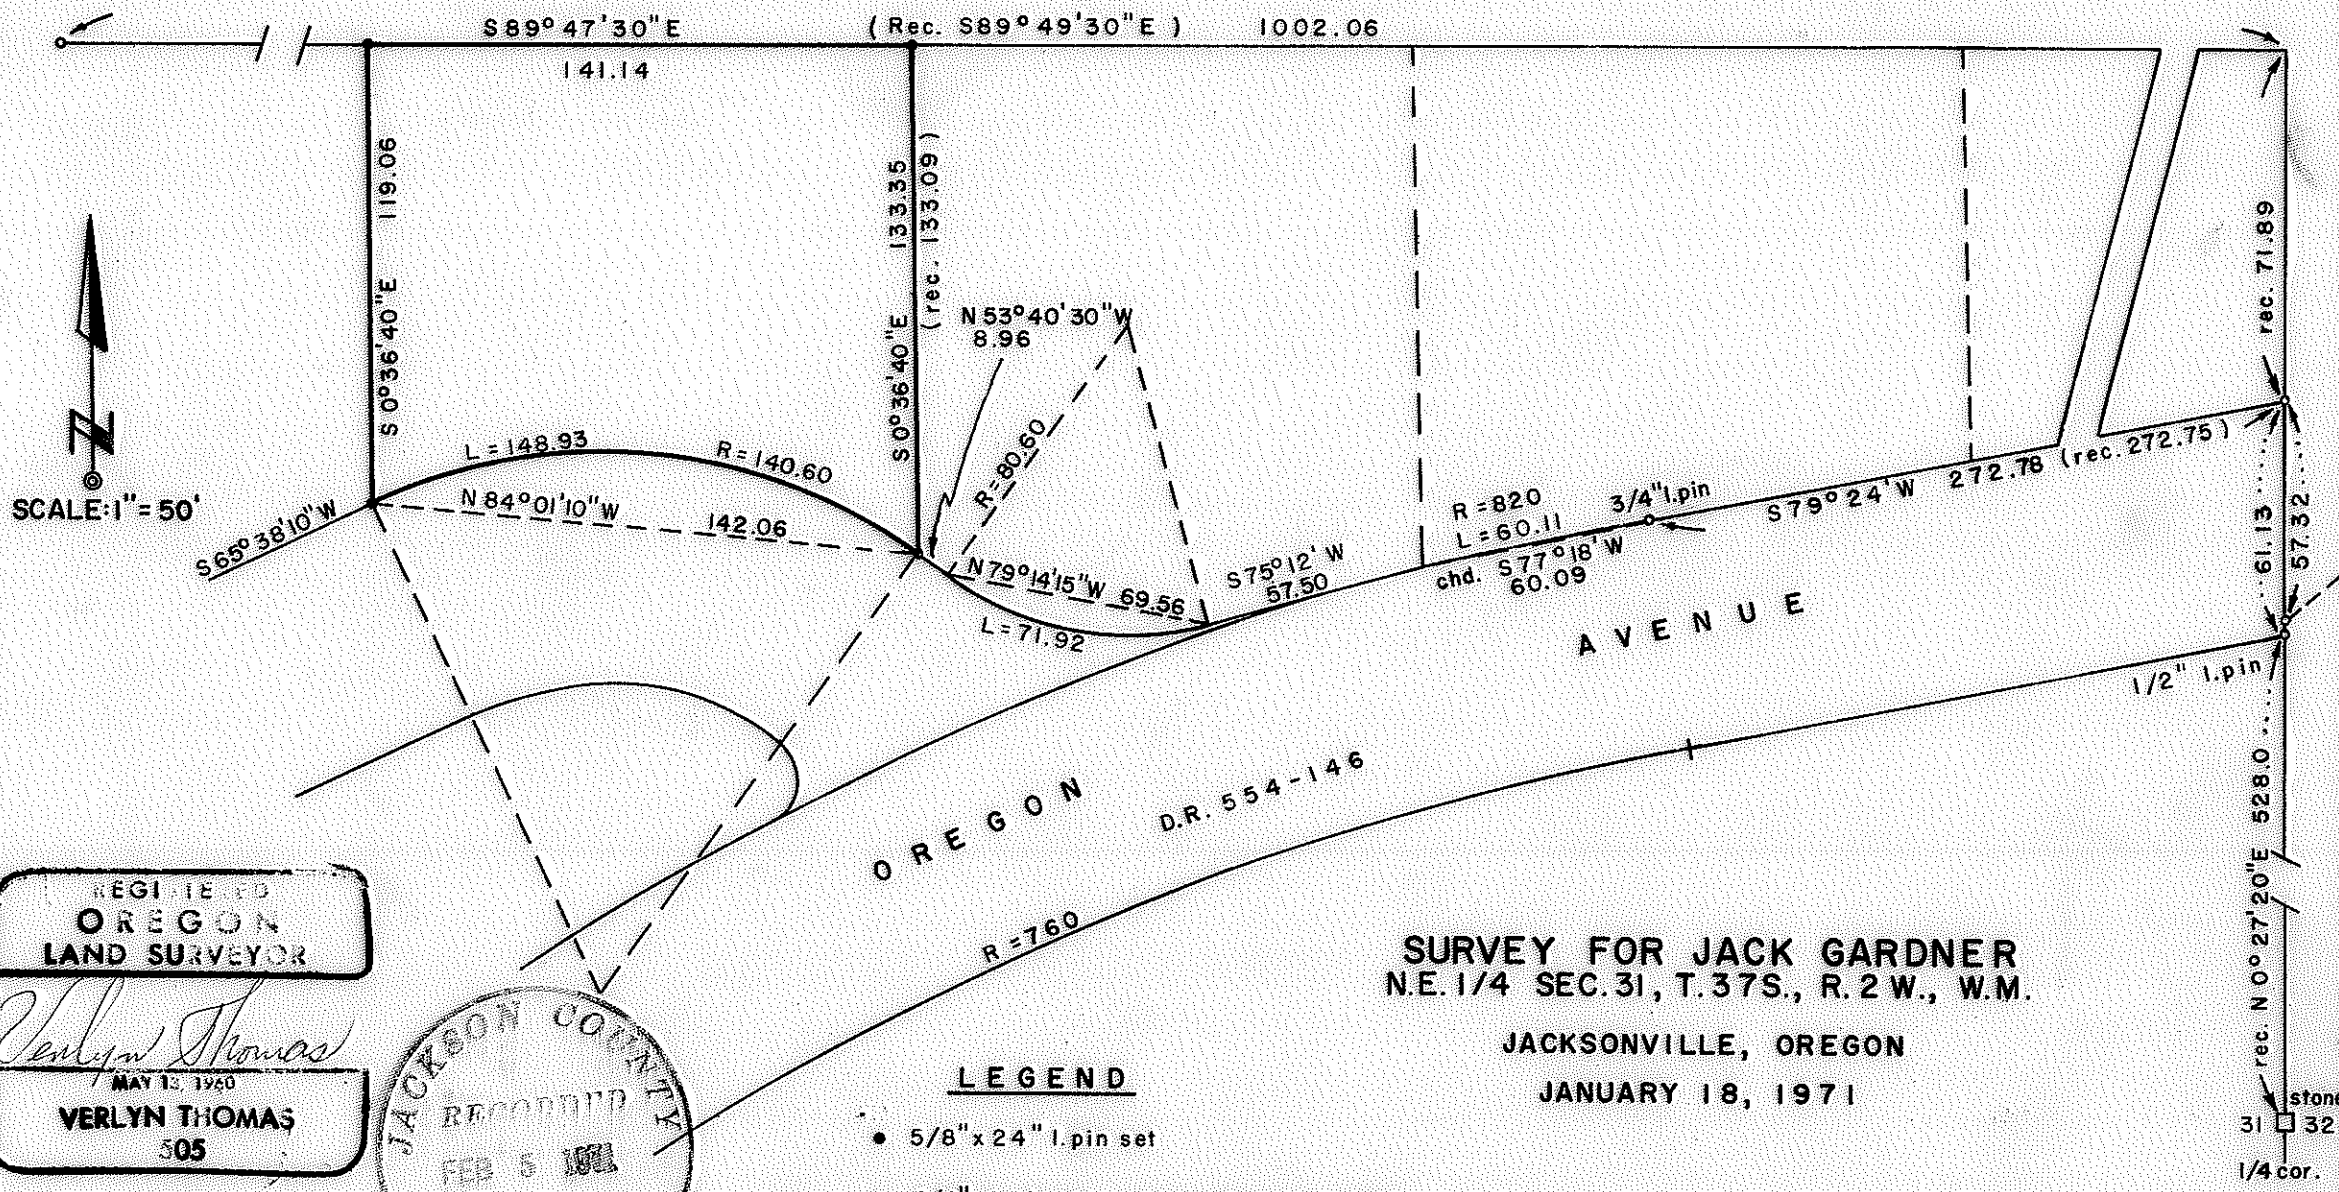

REGISTERED
OREGON
 LAND SURVEYOR

Verlyn Thomas
 MAY 13, 1960
VERLYN THOMAS
 505

JACKSON COUNTY
 RECORDED
 FEB 6 1971
 SURVEYOR

LEGEND

- 5/8" x 24" l. pin set
- 5/8" pin found, unless otherwise noted

SURVEY FOR JACK GARDNER
 N.E. 1/4 SEC. 31, T. 37S., R. 2 W., W.M.

JACKSONVILLE, OREGON
JANUARY 18, 1971

stone
 31 32
 1/4 cor.

SURVEY NARRATIVE TO COMPLY WITH O.R.S. 209.250
REVISED BY CHAPTER 555, O.L. 1963

FOR: Jack Gardner
Post Office Box 533
Jacksonville, Oregon

PURPOSE: To survey and monument a residential parcel according to records furnished surveyor.

PROCEDURE: Recovered monuments as shown on the accompanying Plat and surveyed parcel according to data found on unrecorded plats prepared by L. S. 565, dated August 23, 1965. **Bearings** based on monumented northerly right-of-way of Oregon Avenue. See Recorded Survey Nos. 1987 and 1673.

