


4492

Scale: 1" = 50'
Brgs Per RS 4242

HUENER LANE
(ACADEMY ST.)

PARK STREET

- Fd. 5/8" I. Pin
- Set 5/8" x 30" I. Pin

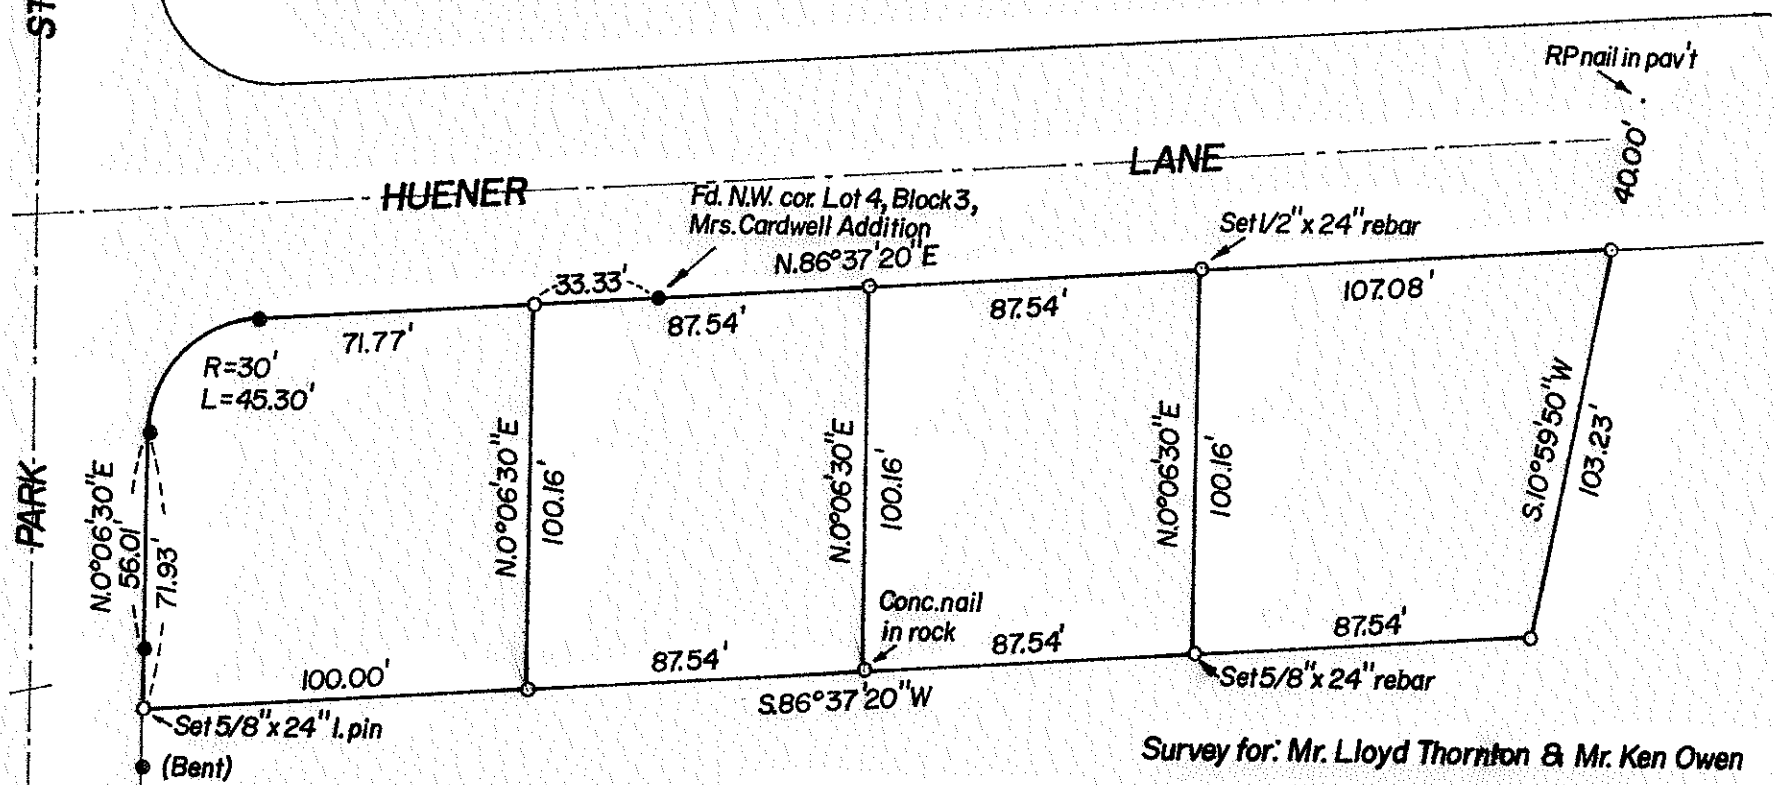

JACKSON COUNTY
REGISTERED
MAR 18 1971
SURVEYOR

REGISTERED
OREGON
LAND SURVEYOR
C. Lind McBeth
JANUARY 12, 1962
C. LIND MCBETH
565

Survey for: Mr. Lloyd Thornton & Mr. Ken Owen
Sited in: S.E. 1/4 Sec. 29, T37S, R2W, W.M.,
City of Jacksonville, Jackson
County, Oregon
Survey by: C. Lind McBeth, L.S., Jacksonville,
Oregon
Date: March 1, 1971

4492

SURVEY NARRATIVE TO COMPLY WITH O.R.S. 209_ 250

Survey for: Mr. Lloyd Thornton Mr. Kenneth Owen
 P.O. Box 525 & P.O. Box 626
 Jacksonville, Oreg. Jacksonville, Oreg.

Survey By: C. Lind McBeth L.S.
 P.O. Box 306
 Jacksonville, Oreg.

Date: March 15 1971

Basis of Bearing: Per R. S. #4242


Precedence of Survey:

1. Found 5/8" iron pin at the Northwest corner Lot 4, Block 3, Mrs. Cardwell's Addn.
2. Found 5/8" iron pin being the S/L of Hueners Lane at the West Line of Beverly Way.
3. Found 5/8" iron pins at the property line curve points at Southeast corners of Huener and Park.
4. Found 5/8" iron pin at the S/L of Academy St. on the East line Park St.

Now having the necessary control for the street lines I staked out a parcel 100 ft. deep from Park St. to the E/L of Mr. Thorntons deed. Having the boundary thus established I divided same into 4 lots as instructed by Mr. Owen.

71-4

REGISTERED
OREGON
LAND SURVEYOR

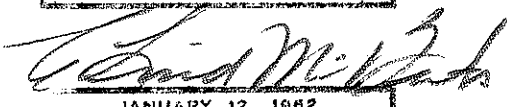

JANUARY 12, 1982
C. LIND MCBETH
565

JACKSON COUNTY
RECORDED
MAR 18 1971
SURVEYOR