

GRESHAM ST

IDAHO ST

HOLLY STREET

STREET

S. 89°45'30" W


104.55

FD 'CITY OF ASHLAND'  
BRONZE DISK IN MON.  
CASE

FD 1 1/2" DIA. BRONZE  
DISK FLUSH WITH  
STREET

NORTH

① FOUND 3/4" PIPE  
N. 844, E. 834

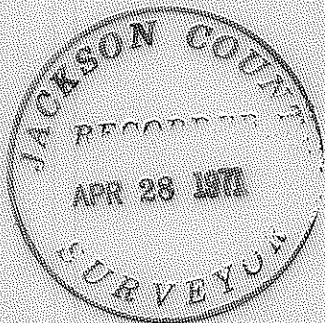

FD 1" DIA. IRON BAR  
17" DEEP

FD 1" IRON PIPE, 20"  
DEEP

1/4 SECTION COR  
FD 3/4" BRONZE  
DISK

104.93

# MAP OF SURVEY

LOCATED IN  
SE 1/4 OF SW 1/4 SECTION 9, T39S. R.1E. WM  
JACKSON COUNTY OREGON  
FOR

## NEIL MANN

REGISTERED  
OREGON  
LAND SURVEYOR

*Everett L. Swain*

JULY 6 1968  
EVERETT L. SWAIN  
759

EVERETT L. SWAIN, ELS. ASHLAND, OREGON  
SCALE: 1" = 100' MARCH 17, 1971  
BASIC OF BEARING U.S.C. 16 S. TRUE BEARING  
8 FOUND MON. AS SHOWN IN  
9 SET 2 1/2" DIA. IRON PIPE TAPPED ALL 759

ASIA

SURVEY NO. 4514

SURVEY NARRATIVE TO COMPLY WITH PARAGRAPH 209.250  
OREGON REVISED STATUTES

SURVEY FOR: Neil Mann  
517 Iowa Street  
Ashland, Oregon

LOCATION: Situated in the Southeast quarter of the Southwest quarter of Section 9, Township 39 South, Range 1 East of the Willamette Base and Meridian, Jackson County, Oregon.

PURPOSE: To survey, monument and prepare legal descriptions for the tracts shown on the accompanying map, per clients instructions.

PROCEDURE: Found street monuments per "City of Ashland" reference notes. With these monuments and additional information compiled by this office, surveyed the tracts as shown on the accompanying map.

March 17, 1971

Everett L. Swain  
Professional Land Surveyor  
Ashland, Oregon

