

NORTH

REGISTERED  
**OREGON**  
 LAND SURVEYOR

*Everett L. Swain*

JULY 8, 1968  
**EVERETT L. SWAIN**  
 759

**MAP OF SURVEY**

LOCATED IN  
 SW 1/4 SEC. 27 & NW 1/4 SEC. 34, T. 37 S. R. 1 W. W. B. & M.  
 JACKSON COUNTY OREGON  
 FOR

**GEORGE P. RENAKER**

JACKSON COUNTY  
 RECORDED  
 JUN 7 1971  
 SURVEYOR

EVERETT L. SWAIN, R.L.S.  
 SCALE: 1"=100  
 BASIS OF BEARING RECORDED SURVEY NO. 692  
 FOUND 1/2" GALV. IRON PIPE  
 FOUND 3/4" CAPPED GAS PIPE  
 FOUND 5/8" IRON PIN  
 SET 5/8" x 24 INCH IRON PIN TAGGED R.L.S. 759  
 ASHLAND, OREGON  
 MAY 24, 1971

SURVEY NARRATIVE TO COMPLY WITH PARAGRAPH 209.250  
OREGON REVISED STATUTES

SURVEY FOR: George P. Renaker  
3940 Barnett Road  
Medford, Oregon

LOCATION: Situated in the Southwest quarter of Section 27 and the Northwest quarter of Section 34, Township 37 South, Range 1 West of the Willamette Base and Meridian, Jackson County, Oregon.


PURPOSE: To survey and prepare a legal description for a parcel of land as shown on the accompanying map, per clients instructions.

PROCEDURE: Recovered the sandstone per recorded survey No. 692 at the Southwest corner of Donation Land Claim No. 58, Township 37 South, Range 1 East. The Southeast corner of Donation Land Claim No. 58 was shown on recorded survey No. 692, but did not indicate any monument had been found or set. After a careful search, found a 1 1/4 inch iron pipe at the Southeast corner of Donation Land Claim No. 58. Verified this pipe by the 1/2 inch reference pipe shown on recorded survey No. 692. The distance shown on said survey is 63.1 feet. My measurement returns a distance of 63.06 feet. From other monuments found and shown on the accompanying map, proceeded to survey and monument that tract of land shown on the accompanying map, per clients instructions.

This survey was made utilizing a Wild T-2 Theodolite and a Hewlett-Packard 3800-A Distance Meter, all in good adjustment.

May 24, 1971

Everett L. Swain  
Professional Land Surveyor  
Ashland, Oregon

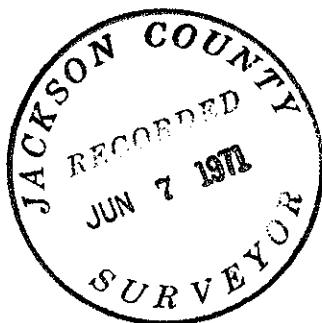

*Everett L. Swain*

