


SCALE 1"=100'
 Basis of Bearings
 Rec. Survey No. 4126

- = Set 5/8" X 30" I. Pin Tagged R.L.S. 638
- = Fd. 5/8" I. Pin (unless otherwise noted)

REGISTERED
 OREGON
 LAND SURVEYOR
George Burrell
 JULY 10, 1924
 GEORGE R. BURRELL
 638

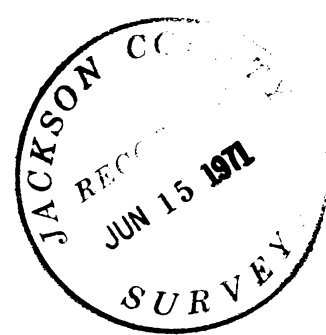

(Re: R.S. No. 4126)

MAP OF SURVEY

Located in D.L.C. No. 46 and 47 T 39S, R 2E and D.L.C. No. 37, 38
 and 39 T 40S, R 2E W.M.
 Jackson County, Oregon
 For: ADRIAN BARATS
 Ashland, Oregon
 By: George Burrell L.S.
 Medford, Ore. June 1971

SURVEY NARRATIVE TO COMPLY WITH O.R.S. 209.250
REVISED BY CHAPTER 555, O.L. 1963

FOR: Adrian Barats
1136 Old Highway 99 S
Ashland, Oregon

PURPOSE: To partition the tract as shown on the accompanying map.

PROCEDURE: The centerline of Old Highway 99 was established as was in Recorded Survey No. 4126 by adopting the mean measurement of the existing pavement. The Northerly and the Southerly Boundary of the overall tract was established along the present fence lines and finalized by agreement (see Doc. 71-06740 O.R., J.C.,O.) as the record location was economically unfeasible to undertake. The Southerly Right of Way of Highway 66 was established according to the O.S.H.D. monuments found. The monuments found along the Westerly line of the tract described in Doc. 67-09570 O.R., J.C.,O. were originally established by Surveyor L.E. Ager in 1966 (survey unrecorded). The monuments set by me at the Northerly and Southerly terminus of this line were established according to L.E. Agers original control, the field notes of which are in my possession.

REGISTERED
OREGON
LAND SURVEYOR

George Burrell

JULY 10, 1964
GEORGE R. BURRELL
638

JACKSON COUNTY
RECORDED
JUN 15 1971
SURVEYOR