



BLK. 59

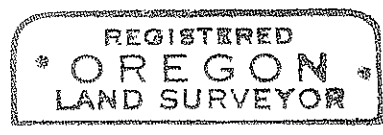

*Edward A. McGinty*

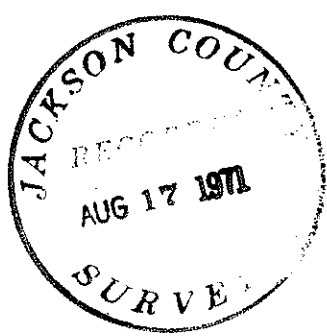

SURVEY IN NW 1/4 SEC 32, T 37S, R 2W, WM.  
CITY OF JACKSONVILLE

FOR  
DANIEL R. THOMPSON  
71-6

BY EDWARD A. MCGINTY  
MEDFORD, OREGON  
APRIL 1971

SCALE 1" = 50'  
● = FD 3/4" I. PIN  
○ = SET 5/8" I. PIN

Survey No. 4582

SURVEY NARRATIVE TO COMPLY WITH O.R.S. 209-250

Survey for: Daniel Thompson 71-6  
Jacksonville,  
Oregon

Survey by: Edward A. McGinty, R.S.  
Medford, Oregon  
May, 1971

Basis of Bearing: Sur. No. 1783

Location of Survey: NW. 1/4 of Sec. 32, T37S, R2W  
Blk. 59 of the Original Town of Jacksonville

Precedence of Survey:

Surveyed tract as shown. From different deed calls on various deeds, found that the northerly line of the tract could have an alternate position.

The northerly line, as surveyed, fits the existing improvements, reasonably, and the apparent intent. The client has been informed about the conflicting calls of possible alternate position of this line.

Monuments set being 5/8 in. iron pins, 24 ins. long, set approx. flush with the surface.

