


4600

4600

PLAT S.19,T.35S,R.2E,W.M.

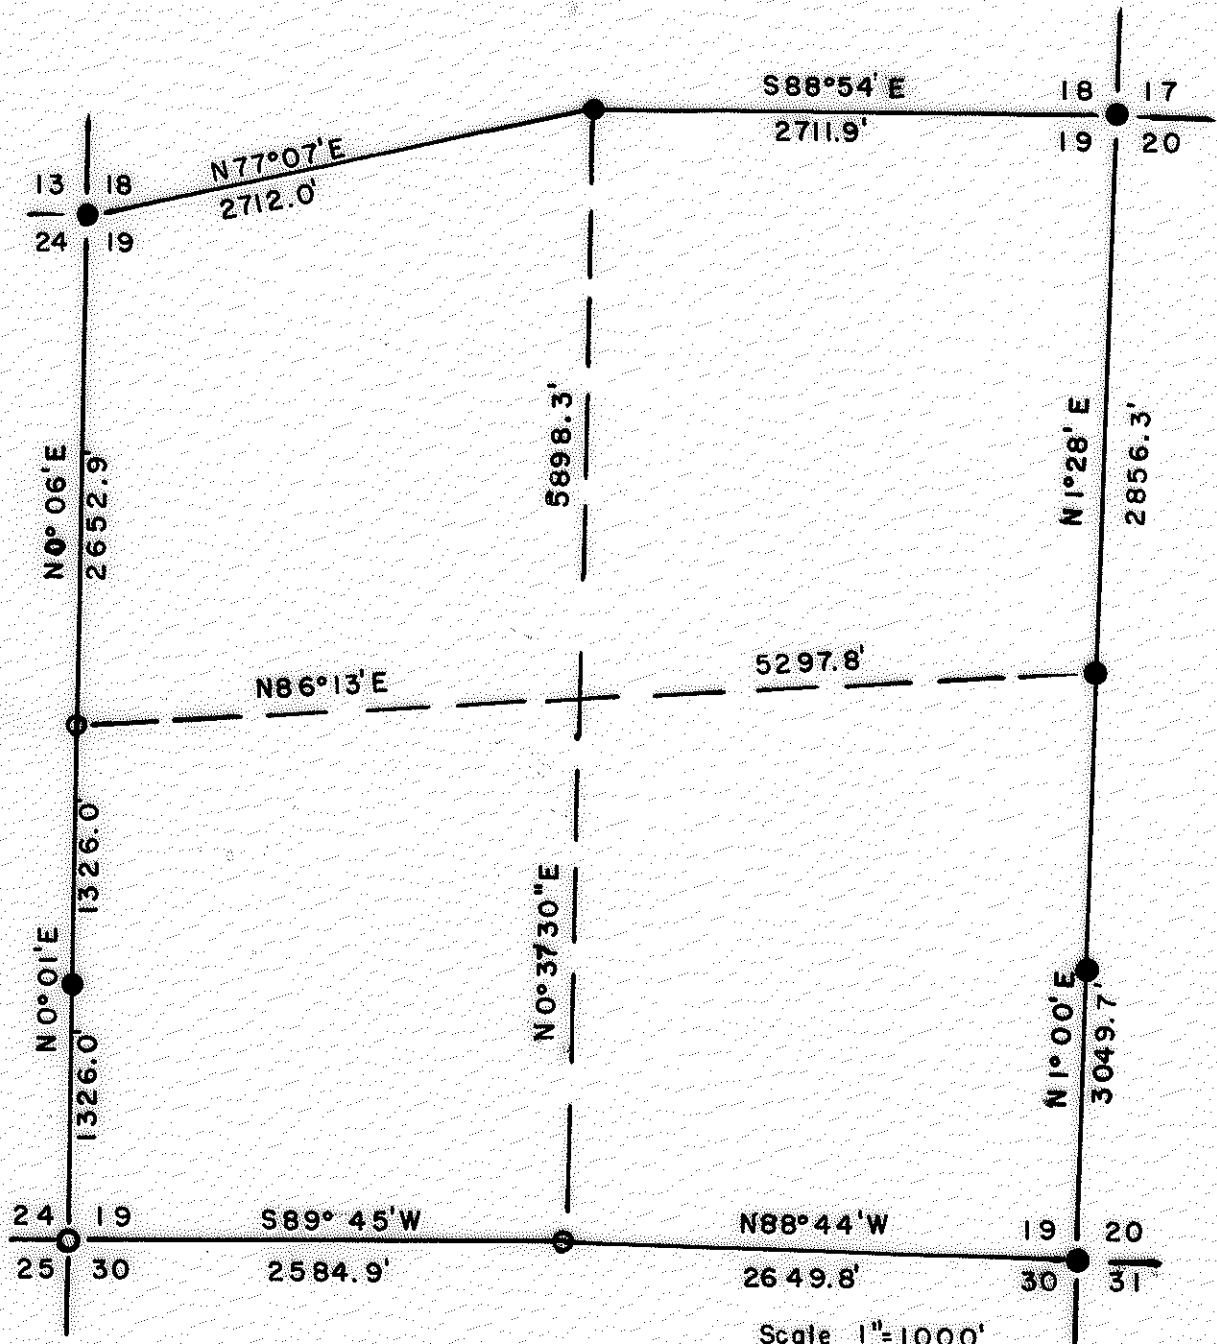

Scale 1"=1000'

Date 8-71


Brass Cap ○

Alum. Cap ●

REGISTERED
 OREGON
 LAND SURVEYOR

Duane A. Smeltzer

OCTOBER 24, 1958
 DUANE A. SMELTZER
 461

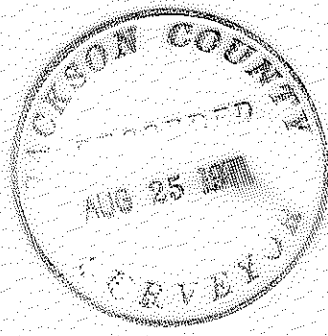

4600

