
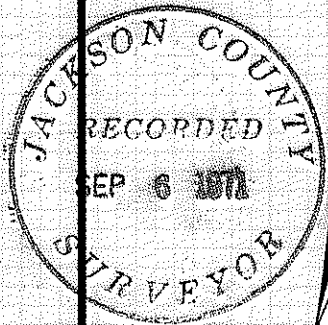


4606

Survey for:

WILLIS H. STIEHL

Located in the SE.1/4
Sec.34, T.35S.R.4W.,W.M.
By: Mark E. Boyden
Sept. 7, 1971

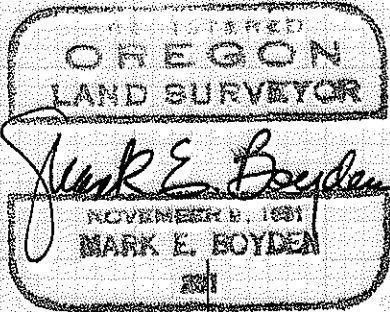

SCALE
1"=100'

Basis of Bearings
Recorded Survey No.3838

- o Fd. 5/8" iron pin flush
- ⊙ Fd. Re-established gov't. corner
- Set 3/4" x 24" iron pin flush
- ⊗ Set 5/8" x 24" iron pin flush

1/4 Cor.
Conc. mon. w/br. disk
8" deep

34
3

839.94'
EARHART
N 89° 56' 30" W

ROAD

34
32

Sec. Cor.
Conc. mon. w/br. disk 8" deep

N 0° 24' 10" W 875.86'

5.06 Acres

S 0° 24' 10" E 733.50'

Proposed Road

Recorded Survey No. 4562

1326.16'

N 89° 57' 40" W 690.00'
S. bd'ry. of the N 1/2 of the
SE 1/4 Sec. 34

S. 1/16 cor.
Sec. s. 34 & 35

S 89° 57' 40" E - 285.03'

S 31° 35' 50" W
0.16'

power line

R=230.00'
L=128.46'

60'

S 0° 24' 10" E 733.50'

R=20.00'
L=31.58'

60'

4606

4606

Survey No. 4606

SURVEY NARRATIVE TO COMPLY WITH O.R.S. 209.250.

FOR: Willis H. Stiehl
P.O. Box 193
Rogue River, Oregon 97537

PURPOSE: To monument and describe a parcel within the Stiehl ownership proposed to be conveyed, being located in the Southeast 1/4, Section 34, Township 35 South, Range 4 West, W.M.

PROCEDURE: On a previous survey by this office for Willis Stiehl, a traverse was run through the East-West centerline of Section 34 and tied Southerly along the East boundary of Section 34 to the East-half of the South boundary of Section 34. This data was then correlated with this survey to determine the South boundary of the North-half of the Southeast Quarter of said Section.

The intent of the conveyance from Willis Stiehl to Mary Ella Quesenberry (See Deed Volume 509, Page 82) was considered to run along said boundary when referring to the bearing of "West".

Ran closed-loop traverse around the subject parcel, computed the true property corners positions and then monumented same as shown on the map to accompany this report.

September 7, 1971

