

4662

S65°03'00"E

68+92.50

S50°06'00"E
B.C.V.S.A.
SURVEY

LOT 12

535.41'

Ely Line PEPPER - TAYLOR SUB.

S12°34'42"E
21.87'

74+27.91


o R.P.

N54°43'20"E
61.20'

S86°48'00"E

LOT 14

SE Cor.

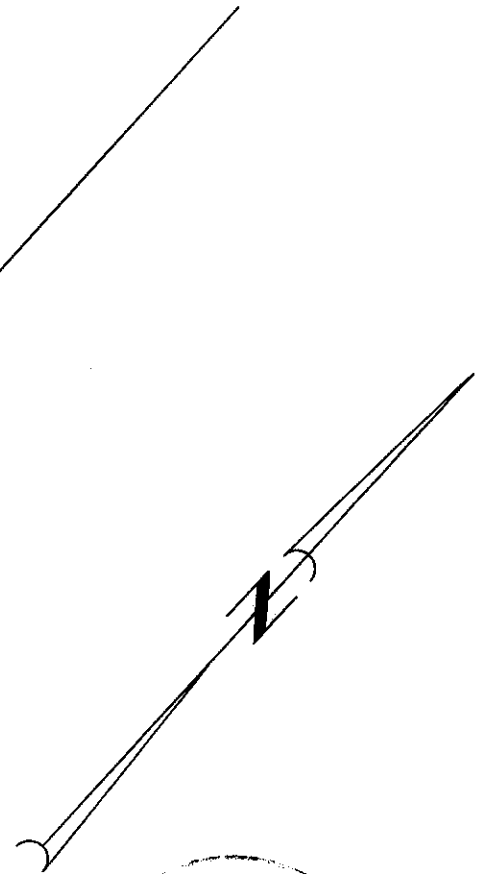

REGISTERED
OREGON
LAND SURVEYOR

Edward A. McGinty

JULY 10, 1953
EDWARD A. MCGINTY
301

530.92'

79+58.83

391.35'

S24°57'00"E

SURVEY IN S1/2 SEC 4 T38S RIW WM.

FOR

PETER KIEWIT & SONS

71-30-2

BY EDWARD MCGINTY

SCALE 1"=100'

MEDFORD OREGON

o = SET 5/8" I.PIN.

SEPTEMBER 1971

4662

Survey No. 4662

SURVEY NARRATIVE TO COMPLY WITH O.R.S. 209-250

Survey for: Peter Kiewit & Sons
3815 Crater Lake Hwy
Medford, Oregon

Survey by: Edward A. McGinty, R.S.
Medford, Oregon
Sept. 1971

Basis of Bearing: P-line BCVSA Survey

Precedence of Survey:

During survey for BCVSA the tie to corner lot 14 of Pepper-Taylor Sub-division was referenced and later destroyed by construction.

This corner was replaced in its original position with a 5/8 in. x 24 in. iron pin, set approx. flush with the surface.

71-30-2

