-4678

SURVEY NARRATIVE TO COMPLY WITH PARAGRAPH 209.250

OREGON REVISED STATUTES

JACKSON COUNTY RECORDED NOV 10 1971 SURVEYOR

Survey for: Wayne & Dorothy Buchanan
1700 East Main Street
Ashland, Oregon 97520

Survey by : Charles H. Hurst, L.S.
28 North Oakdale
Medford, Oregon 97501

Bearing : Based on the meridian for Recorded Survey No. 1980

Purpose : To monument the lines shown for fence construction

Procedure : Utilization of survey control established during the course of Recorded Survey No. 2484

SCALE: 1" = 200'

SURVEY IN DONATION LAND CLAIM NO. 45, TWP. 39 SOUTH, RANGE 1 EAST, WILLAMETTE MERIDIAN JACKSON COUNTY, OREGON

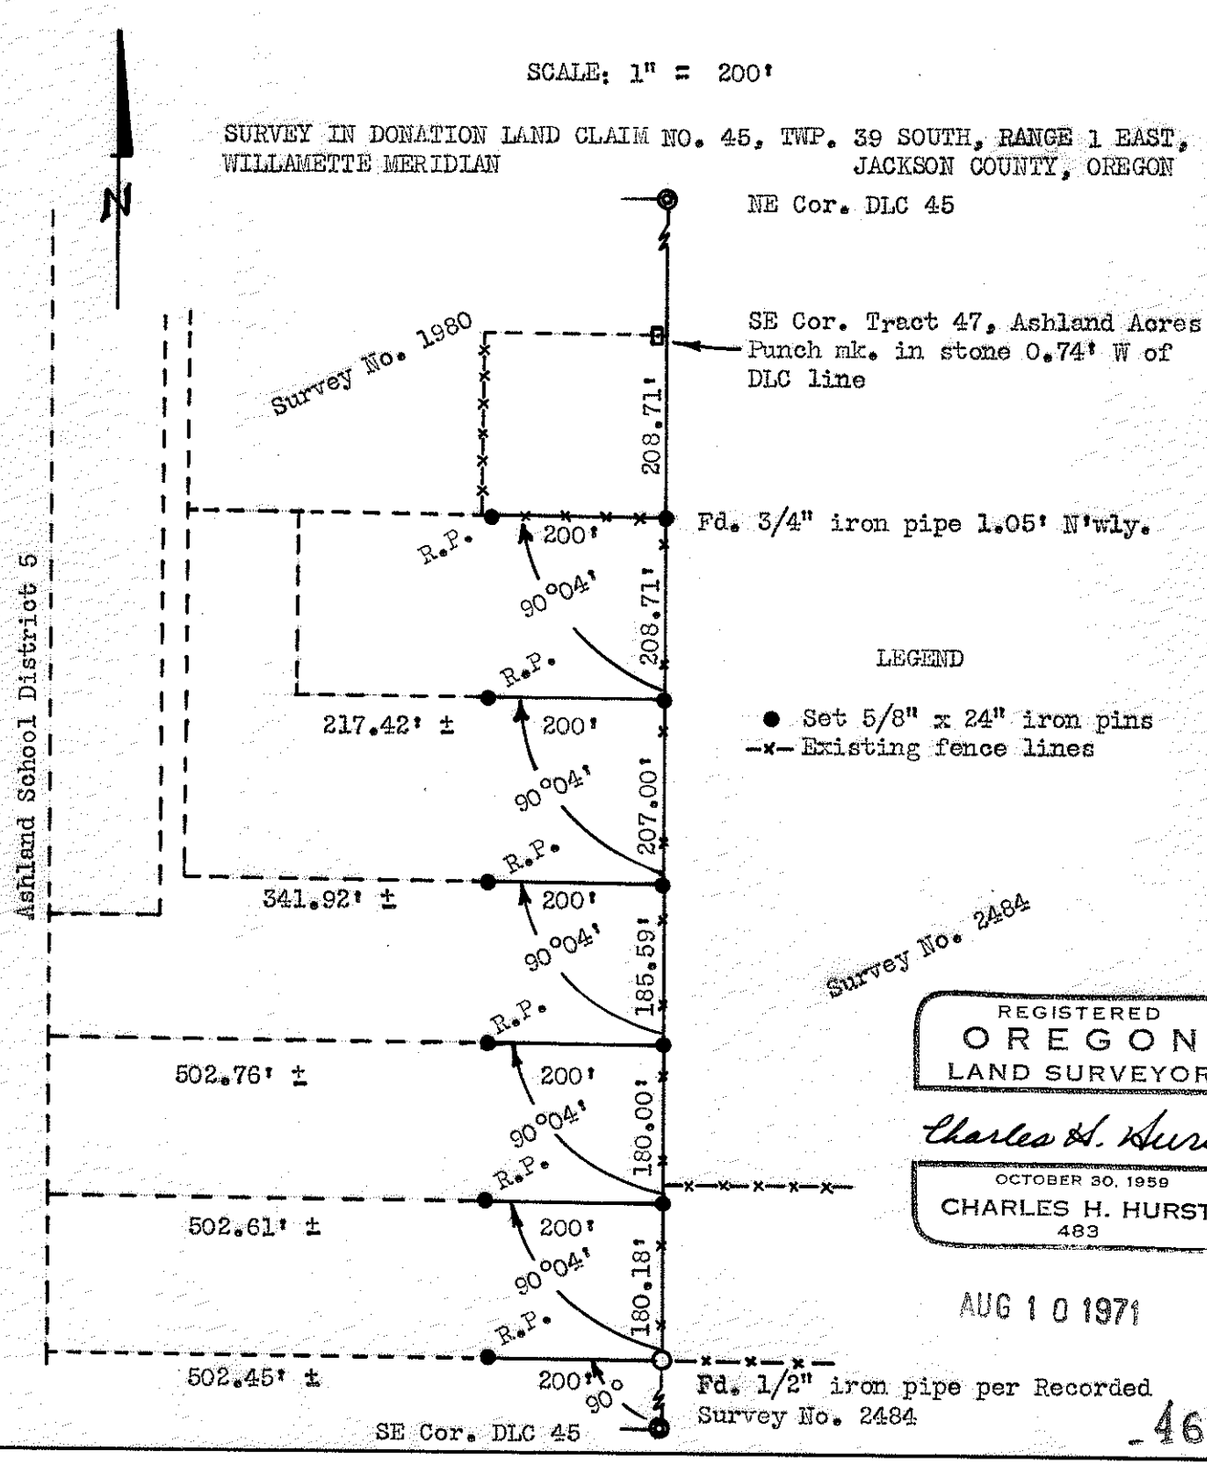

REGISTERED OREGON LAND SURVEYOR

Charles H. Hurst

OCTOBER 30, 1959
CHARLES H. HURST
483

AUG 10 1971

-4678