

**SURVEY IN 60V'T. LOT 3, SECTION 16
T. 34 S., R. 1 W., W.M.,
JACKSON COUNTY, OREGON**

**FOR
ELLIS C. ALSOP**



SCALE 1" = 100'

**SURVEY BY
CHARLES H. HURST, L.S.
MEDFORD, OREGON**

LEGEND
● SET 5/8" X 24" IRON PINS
⊙ FD PIPES PER R.E. NO. 2037

**REGISTERED
OREGON
LAND SURVEYOR**

Charles H. Hurst

OCTOBER 30, 1959
CHARLES H. HURST
483

MAR 15 1971

SURVEY NARRATIVE TO COMPLY WITH PARAGRAPH 209.250

OREGON REVISED STATUTES

Survey for: Ellis C. Alsop
 P.O. Box 703
 Shady Cove, Oregon 97539

Survey by : Charles H. Hurst, L.S.
 28 North Oakdale
 Medford, Oregon 97501

Bearing : Based on the meridian for Recorded Survey No. 3633

Purpose : To monument the division line between the two tracts shown.

PROCEDURE


Survey control was recovered relative to Parcel No. 5 as surveyed by R.E. No. 2037 in August of 1946 to which descriptions were originally written .

Said control was subsequently oriented to that of Recorded Survey No. 3633.


The base line Southerly between undisturbed monuments was determined and record distances and deflection angles was held therefrom with the exception of the southerly boundary which is controlled by the monument found at the southeast corner.

Monuments set by unknown parties and those monuments obviously disturbed were not held in place.

The true point of beginning being 90° from the southerly boundary of the parent tract, the record course of 219 feet is obviously incorrect.

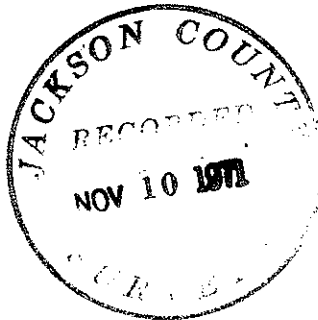

Charles H. Hurst

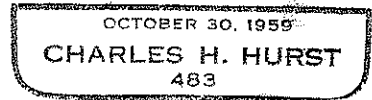

MAR 15 1971