

Survey No. 4696

SURVEY NARRATIVE TO COMPLY WITH O.R.S. 209-250

Survey for: Ashland Mill Corp.
George Williams
P.O. Box 51
Ashland, Oregon

Survey by: Edward A. McGinty, R.S.
Medford, Oregon
October, 1971

Location: Section 26, T40S, R1W

1/4 CORNER BETW. SECS. 25 & 26, T40S, R1W, WM. Jackson Co. Oregon

Found granite stone, scribe 1/4
Found Elk Lbr. Co. tag, set by R.C.E. on a now 4 in. snag, adj. to
corner. Reset tag, fir NEly. Replaced stone with a 5/8 x 30 in.
iron pin with a stone along the north side, from which

Original Bearing, being a fir snag with 1/4 scribe visible, bears
N.48 3/4°E., 31.68 ft. to face instead of N.40°E., 31.68 ft.


The stump of original bearing tree (downed snag) bears N.78°W.,
33.00 ft. to center.

New Reference

Shasta fir, 8 ins. diam., bears N.21°35'W ft., Scribe 1/4 BT
Shasta Fir, 16 ins. diam., bears N.26°06'E., 31.68 ft., Scrib 1/4 BT.

Corner of Sections 25, 26, 35 & 36 bears S.0°23'34"E., 2584.59 feet.

71-35

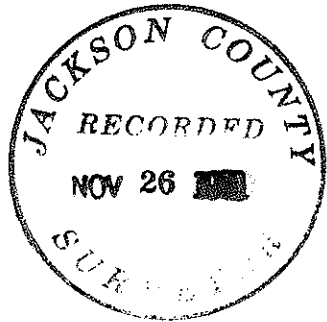

Edward A. McGinty

