

-4700

FD. BRASS CAP IN MONT.

FD. 1" I.PIN

BARNETT ROAD

ROAD

N89°42' W

30'

150.00'

N89°42'00"W

250.00'

100.00'

250.00'

S89°42'00"E

100.00'

N0°01'40"E

S0°01'40"W

MURPHY ROAD


STATE ST.

ST.

30.00'

30.00'

FREEMONT ST.

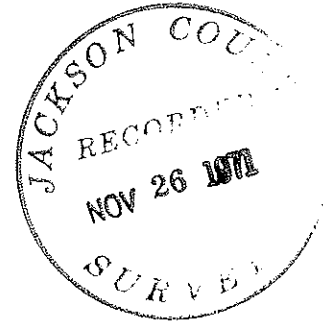

REGISTERED OREGON LAND SURVEYOR

Edward A. McGinty

JULY 10, 1953 EDWARD A. MCGINTY 301

SURVEY IN NW1/4 SEC 33 T38S R1W WM.

FOR

ROGUE VALLEY PHYSICIANS SERVICE

71 - 37

BY EDWARD MCGINTY

SCALE 1" = 50'

MEDFORD OREGON

○ = SET 5/8" I.PIN

NOVEMBER 1971

● = FD 5/8" I.PIN

★ = FD. 1" I. BOLT

-4700

SURVEY NO. 4700

SURVEY NARRATIVE TO COMPLY WITH O.R.S. 209-250

Survey for: Rogue Valley Physicians Svc.
Marquess & Marquess, Engineers
Goldy Building
Medford, Oregon

Survey by: Edward A. McGinty, R.S.
Medford, Oregon
November, 1971

Basis of Bearing: Center Line of Barnett Road.

Precedence of Survey:

Surveyed the outside boundry of two tracts of land. (100 x 200 and 100 x 50).

1st Tract being a strip parallel to Barnett Road and 150 feet south of the South line of Barnett Rd., abutted on the West by Murphy St.

The 2nd Tract calls to the above described Tract (note, found minor diff. in bearing).

Found monuments as shown. See city survey of Barnett Rd. No. 4299. See Sub-divisions to the South for Murphy rd. control.

(71-37)

