

4713

Sec.34, T36S
Sec.3, T37S

Fd. 5/8" I. Pin

S52°59'20"W, 251.81'

(Rec. N.37°02'20"W)
N.37°00'40"W, 254.00'

1.28 Acres

S.45°43'40"E, 192.46'

R=140.00'
L=108.00'

S.85°37'40"E,
102.15'

N.13°21'50"E,
60.47'


27.62'

Fd. 5/8" I. Pin

Dry Creek County Rd.

S.45°54'15"W,
119.77'

92.60'
F. 5/8" I. Pin
RS 33335

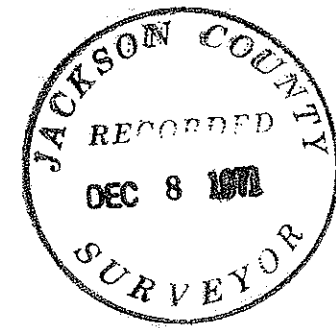

Scale: 1" = 50'
• = Set 5/8" x 24" I. Pin
Basis of Brgs / RS 3335

REGISTERED
OREGON
LAND SURVEYOR
C. Lind McBeth
JANUARY 12, 1962
C. LIND MCBETH
565

SURVEY FOR: Mr. M.E. Dyer
SITUATED IN: NE 1/4, Sec. 3, T37S,
RIW, WM, Jackson County, Oreg.
BY: C. Lind McBeth, L.S., Jacksonville,
Oregon, Sept. 23, 1971

4713

SURVEY NARRATIVE TO COMPLY WITH O. R. S. 209-250

Survey For: Mr. M. E. Dyer

4155 Dry Creek Rd.

Medford, Oregon

Date: 12-6-71

Purpose of Survey: To establish boundaries of a parcel of
land in the NE 1/4 Sec. 3 T 37 S R 1 W.
W. M.

Basis of Bearing: Per R.S. #3335

Survey Procedure: Found the various pins per previous surveys
as indicated on the plat. Layed out the West
and North Boundaries per client instructions.
Set 5/8" by 24" iron pins at each of the corners.

