
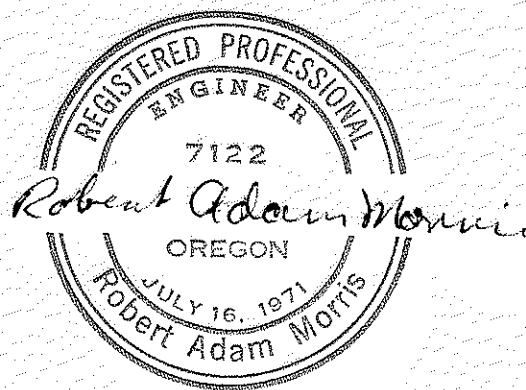


From which a 23" Douglas fir bears N8° W a distance of 59.7 feet scribed
CSS 1/64 S3 - BT and a 13" ponderosa pine bears N 49½° E a distance of 20.5
feet, scribed CSS 1/64 S3 - BT.

Distances and bearings to bearing trees taken to the face of the upper
blaze and magnetic declination set at 20° E.

December 3, 1971

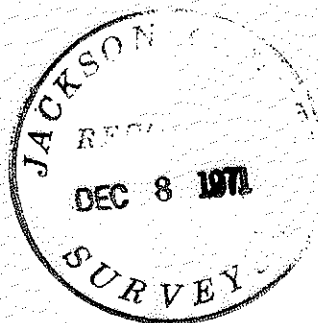

At the W 1/16 corner common to Sections 3 and 10 set a 1" x 36" galvanized iron pipe 33" in the ground, capped with a 1 1/2" to 1" bell reducer, filled with pot metal and stamped as shown below:

RE 7122
W 1/16
3
10
T33S R2E
1971

From which an 11" Douglas fir bears S65° W a distance of 35.0 feet scribed W 1/16 S10 - BT and a 13" cedar bears N30° W a distance of 68.4 feet, scribed W 1/16 S3 - BT.

At the section corner common to Sections 3, 4, 9 and 10 found a 2" iron pipe as described in the 1937 County Surveyor notes.

At the S 1/16 corner common to Sections 3 and 4 found a 1/2" iron pipe as set by C. Z. Boyden in 1937.

At the 1/4 corner common to Sections 3 and 4 found a 1" iron pipe as set by C. Z. Boyden in 1937.

At the C 1/4 corner Section 3 set a 1" x 36" galvanized iron pipe 16" in the ground to bedrock, further supported by a mound of stones and capped with a 1 1/2" to 1" bell reducer and stamped as shown below:

RE 7122
C 1/4
+
Sec.3
T33S R2E
1971

From which a 24" Douglas fir bears S50° E a distance of 77.3 feet scribed C 1/4 S3 - BT, a 13" ponderosa pine bears N 34 1/2° E a distance of 74.1 feet scribed C 1/4 S3 - BT, a 11" white oak bears N66° W a distance of 78.5 feet scribed C 1/4 S3 - BT and a 13" ponderosa pine bears S80° W a distance of 81.7 feet scribed C 1/4 S3 - BT.

At the C S 1/16 Section 3 set a 1" x 36" galvanized iron pipe 36" in the ground, capped with a 1 1/2" to 1" bell reducer, filled with pot metal and stamped as shown below:

RE 7122
CS 1/16
+
SEC 3
T33S R2E
1971

From which a 13" Douglas fir bears S77° E a distance of 106.0 feet scribed CS 1/16 S3 - BT and a 20" Douglas fir bears S38 1/2° W a distance of 77.2 feet scribed CS 1/16 S3 - BT.

At the CSS 1/64 corner Section 3 set a 1" x 36" galvanized iron pipe 32" in the ground, capped with a 1 1/2" to 1" bell reducer, filled with pot metal and stamped as shown below:

RE 7122
CSS 1/64
+
SEC 3
T33S R2E
1971

From which a 9" ponderosa pine bears S 28 $\frac{1}{2}$ ⁰ E a distance of 43.1 feet scribed 1/4 S2 - BT and a 19" ponderosa pine bears N 25 $\frac{1}{2}$ ⁰ E a distance of 21.3 feet scribed 1/4 S35 - BT.

At the section corner common to Sections 34 and 35, Township 32 South, Range 2 East and Sections 2 and 3, Township 33 South, Range 2 East found no evidence of the original corner. At the proportionate distance set a 1" x 36" galvanized iron pipe 34" in the ground, capped with a 1 $\frac{1}{2}$ " to 1" bell reducer, filled with pot metal and stamped as shown below:

		RE 7122	
34	35	T32S	
3	2	T33S	
		R2E	
		1971	

From which a 15" Douglas fir bears S 52⁰ E a distance of 34.7 feet scribed S2 T33S R2E - BT, a 15" Douglas fir bears S 51⁰ W a distance of 72.6 feet scribed S3 T33S R2E - BT, a 11" Douglas fir bears N 61 $\frac{1}{2}$ ⁰ W a distance of 64.0 feet scribed S34 T32S R2E - BT and a 12" Douglas fir bears N10 $\frac{1}{2}$ ⁰ E a distance of 49.2 feet scribed S35 T32S R2E - BT.

At the E 1/16 corner common to Section 34, Township 32 South, Range 2 East and Section 3, Township 33 South, Range 2 East set a 1" x 36" galvanized iron pipe 34" in the ground, capped with a 1 $\frac{1}{2}$ " to 1" bell reducer, filled with pot metal and stamped as shown below:

		RE 7122	
		E 1/16	
34	T32S		
3	T33S		
		R2E	
		1971	

From which a 10" Douglas fir bears S 14⁰ W a distance of 19.2 feet, scribed E 1/16 S3 - BT and a 9" Douglas fir bears N 48⁰ W a distance of 23.1 feet, scribed E 1/16 S34 - BT.

At the 1/4 corner common to Section 34, Township 32 South, Range 2 East and Section 3, Township 33 South, Range 2 East found a 1" iron pipe as described in the 1937 County Surveyor re-establishment notes.

At the 1/4 corner common to Sections 2 and 3, found no evidence of the original corner. At the proportionate distance set a 1" x 36" galvanized iron pipe, 34" in the ground, capped with a 1 $\frac{1}{2}$ " to 1" bell reducer filled with pot metal and stamped as shown below:

		RE 7122	
		1/4	
3	2		
T33S	R2E		
		1971	

From which a 11" ponderosa pine bears N56 $\frac{1}{2}$ ⁰ W a distance of 45.0 feet scribed 1/4 S3 - BT and a 8" Douglas fir bears S62⁰ E a distance of 34.9 feet scribed 1/4 S2 - BT.

At the Section corner common to Sections 2, 3, 10 and 11 found a 2" iron pipe as described in the 1933 County Surveyor re-establishment notes.

At the 1/4 corner common to Sections 3 and 10 found a 1" iron pipe as described in the 1963 County Surveyor re-establishment notes.

SURVEY NARRATIVE TO COMPLY WITH O.R.S. 209.250


FOR: Boise Cascade Corporation
 P. O. Box 100
 Medford, Oregon 97501

PURPOSE: To re-establish lost corners in Township 32 South, Range 2 East W.M., and to set sectional subdivision corners in Section 3, Township 33 South, Range 2 East, W.M.


PROCEDURE: Ran a random transit traverse over the lines shown on the attached map with a 1-minute transit and a 200-foot steel tape. Bearings were obtained by solar observation and all traverses not closed were traversed twice.

At the 1/4 corner common to Section 36, Township 32 South, Range 2 East and Section 1, Township 33 South, Range 2 East, found a 1" iron pipe as described in the 1952 County Surveyor re-establishment notes.

At the section corner common to Sections 35 and 36, Township 32 South, Range 2 East and Sections 1 and 2, Township 33 South, Range 2 East found no evidence of the original corner. Set at the proportionate distance a 1" x 36" galvanized iron pipe 35" in the ground, capped with a 1 1/2" to 1" bell reducer filled with pot metal and stamped as shown below:

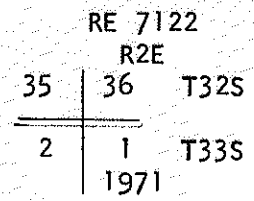

From which a 10" Douglas fir bears N 72° E a distance of 62.1 feet, scribed S36 T32S R2E - BT, a 30" Douglas fir bears S 61 1/2° W a distance of 76.9 feet scribed S2 T33S R2E - BT and a 7" ponderosa pine bears N 30 1/2° W a distance of 38.5 feet scribed S35 T32S R2E - BT. There were no suitable trees in Section 1. Because the corner pipe sets in the edge of a large pond and is under water for a portion of the year set a 1" x 36" galvanized iron pipe 33" in the ground capped with a 1 1/2" to 1" bell reducer stamped as shown below:

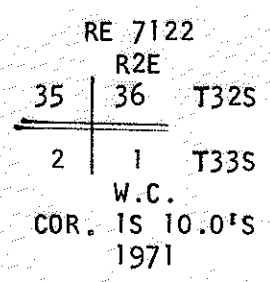

This pipe bears due North a distance of 10.0 feet from the corner pipe.

At the 1/4 corner common to Section 35, Township 32 South, Range 2 East and Section 2, Township 33 South, Range 2 East found no evidence of the original corner. Set at the proportionate distance a 1" x 36" galvanized iron pipe 35" in the ground capped with a 1 1/2" to 1" bell reducer, filled with pot metal, and stamped as shown below:

