


SCALE 1" = 100'
 Basis of Bearings R.S. No. 2109

- o = Set 5/8" X 30" iron pin (tagged RLS638)
- = Found mon. as noted

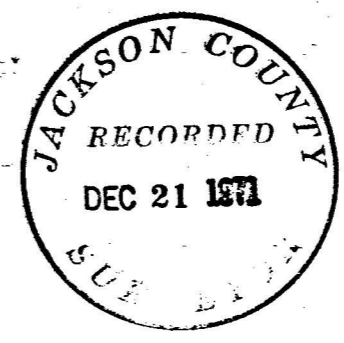

REGISTERED
 OREGON
 LAND SURVEYOR
George Burrell
 JULY 10, 1964
 GEORGE R. BURRELL
 638

MAP OF SURVEY
 Located in SW₄ NW₄ Sec. 20, T38S, R1W
 For: CLEE TOOVEY TALENT, ORE.
 By: George Burrell Surveyor Dec 1971

SURVEY NO. 4727

SURVEY NARRATIVE TO COMPLY WITH O.R.S. 209.250
REVISED BY CHAPTER 555, O.L. 1963

FOR: Clee Toovey
5320 Coleman Cr. Rd.
Talent, Oregon

PURPOSE: To partition the tract described in O.R. 68-08576,
J.C.,O. as shown on the accompanying map.

PROCEDURE: The monuments of Recorded Survey No. 2109 were used
as control in establishing the East line of the SW
1/4 of the NW 1/4 and the approximate centerline of
Coleman Creek Road. The West boundary line of the
tract created by this survey was located according
to the clients instructions.
An error in bearing was discovered on Recorded Survey
No. 2109 which was corrected by this survey. The
centerline road bearing of N 86° 13' 30" E on Recorded
Survey No. 2109 should be N 86° 18' 30" E.
Consultation with Ed McGinty, Surveyor revealed this
error to be a drafting error only, and therefor no
monuments positions were in error. Using the corrected
bearing the witness corner ties shown on Recorded
Survey No. 4208 and No. 4325 were recalculated and
shown on the accompanying map.



George Burrell

