

1793

FD 3/4" IRON PIPE  
N.W. COR. LOT 22 BL. 2

LOT 22

N 89° 50' 40" W  
628.71'

S 89° 50' 40" E  
135.00'

FD 1/2" IRON PIN

S 89° 50' 50" E  
135.00'

FD 1/2" IRON PIN

S 89° 50' 50" E  
135.00'

S 89° 50' 50" E  
493.38'

LOT 21

N 89° 51' 10" W  
493.00'

S 89° 51' 10" E  
135.00'

FD 1/2" IRON PIN

FD 1/2" IRON PIN

LOT 20

N 89° 51' 10" W  
492.66'

S 89° 51' 10" E  
135.00'

347.97'

173.99'

173.98'

S 0° 25' 20" W  
173.98'

169.00'

169.00'

169.005'

AVE.

LAKE

CRATER

GRANDVIEW AVE.

FOUND CITY MONUMENT

SUZANNA ST.

FOUND CITY MONUMENT

GRANDVIEW AVE.



MAP OF SURVEY  
LOCATED IN  
LOTS 20 & 21 BLOCK 2  
ROGUE VALLEY HEIGHTS  
SEC. 18, T. 37 S., R. 1 W., W. M.  
JACKSON COUNTY OREGON  
FOR

**JOHN KEITH, KENNETH KEITH  
& RALPH HUTCHINS**

J. A. HOFFBUHR, REG. L. S., MEDFORD, OREGON

SCALE, 1" = 100'

JULY 6, 1966

BASIS OF BEARING -

R/S NO. 2042

○ = SET 5/8" X 24" STEEL REIN. PIN

REVISED DECEMBER 2, 1971

REGISTERED  
OREGON  
LAND SURVEYOR

*J. A. Hoffbuhner*


J. A. HOFFBUHR

FD 3/4" IRON PIPE  
S.E. COR. LOT 14 BL. 2

SURVEY NARRATIVE TO COMPLY WITH PARAGRAPH 209.250  
OREGON REVISED STATUTES

SURVEY FOR: Kenneth Keith  
616 East Carson  
Space 2-10  
Carson, California 90745



LOCATION: Tract situated in Lot 21, Block 2, Rogue Valley  
Heights, Section 18, Township 37 South,  
Range 1 West, Willamette Meridian, Jackson County,  
Oregon.

PURPOSE: To revise the boundary of the Kenneth Keith parcel.

PROCEDURE: Found the 5/8 inch iron pins set on Recorded Survey  
No. 3329. The pins on the Northerly side of the 40.00 foot drive  
were relocated 14.00 feet Northerly on line, increasing the drive  
width to 54.00 feet.

Basis of bearings--Recorded Survey No. 3329.

December 14, 1971

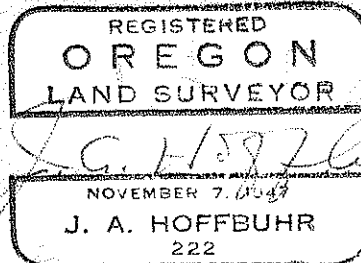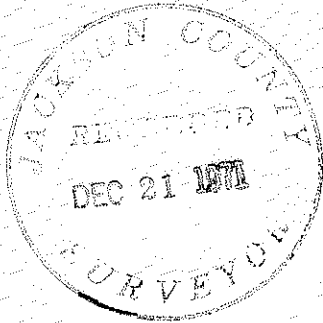

J. A. Hoffbuhr  
Registered Land Surveyor