

4752

4752

SURVEY FOR ARTHUR BROYLES
LOT 5, BLOCK I, HILES LARK MEADOWS SUBDIVISION
Jackson County, Oregon

April 28, 1971



SCALE 1" = 80'

LEGEND


- Monument Found
- 5/8" x 24" Iron Pin set



**REGISTERED
 OREGON
 LAND SURVEYOR**

Verlyn Thomas

MAY 14, 1960
VERLYN THOMAS
 03

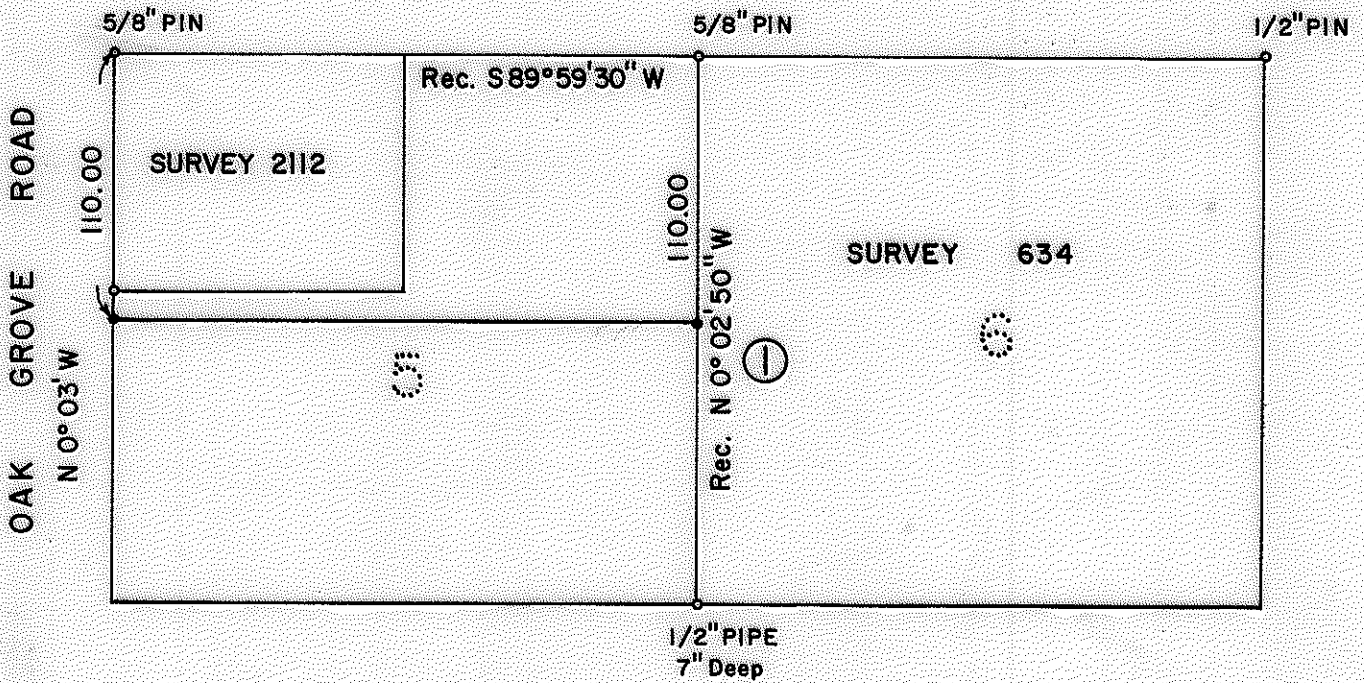

SURVEY BY VERLYN THOMAS, PROFESSIONAL LAND SURVEYOR, MEDFORD, OREGON

4752

SURVEY NARRATIVE TO COMPLY WITH O.R.S. 209.250
REVISED BY CHAPTER 555, O.L. 1963

FOR: Arthur Broyles
1111 Oak Grove Road
Medford, Oregon

PURPOSE: To create a partition line, as directed by client.

PROCEDURE:

Recovered monuments previously established by Recorded Survey Nos. 634 and 2112, and monumented division line as shown on the accompanying plat.

