

4753

SURVEY FOR KEY PROPERTIES

SEC 4, T. 36 S., R. 2 W., W. M.

Jackson County, Oregon

August 7, 1971

32 | 33
5 | 4

TRESHAM LANE

Fd. 5/8" I. Pin

33 1/4 COR.

S 89° 59' 05" W
600.00


360.00

N.W. COR. LOT 14
Fd. 1" I. Pipe

S 0° 00' 55" E
900.00

N 0° 00' 55" W
900.00

600.00
N 89° 59' 05" E

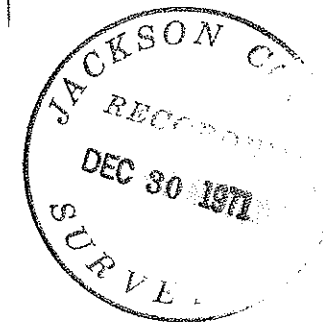

REGISTERED
OREGON
LAND SURVEYOR

Verlyn Thomas

MAY 12, 1960
VERLYN THOMAS
505

SCALE 1" = 100'

• 5/8" x 24" Iron Pin Set

BASIS OF BEARING:

SURVEY NO. 2915

4753

SURVEY NARRATIVE TO COMPLY WITH O.R.S. 209.250
REVISED BY CHAPTER 555, O.L. 1963

FOR: Key Properties
800 East Main
Medford, Oregon

PURPOSE: To survey and monument a 600' x 900' tract according to
furnished legal description.

PROCEDURE:

Established the center-line of Tresham Lane between the spike
at the Northwest corner of Section 4, and the 5/8" iron pin at
the North quarter corner of said Section 4. From this line,
and the 1" iron pipe found for the Northwest corner of Lot 14
of South Forty Subdivision, surveyed and monumented said tract
as shown on the accompanying plat.

